

LOWNDES
G 155
4-25-73

MISSISSIPPI
BOARD OF WATER COMMISSIONERS
416 North State Street
Jackson, Mississippi 39201

CODEL

WATER WELL DRILLERS LOG

4-25 1973 W. J. REEVES & SON LOWNDES
date well completed firm name county well located

LANDOWNER: H & J. BUILDER

description of formations encountered

from

to

MASONIC S/D

CLAY

0

8

COLUMBUS

(mailing address)

SD & GRAVEL

8

31

BLUE CLAY

31

83

" SAND

33

37

" CLAY

37

78

" SAND

75

88

" CLAY

88

94

" SAND

94

116

" CLAY

116

120

WELL LOCATION:

sec. 11 T 18 S R 1 E CW
1/2 miles E of COLUMBUS
(distance) (direction) (nearest town)

WELL PURPOSE: HOME
(home, irrigation, municipal, industrial)

WELL COMPLETION DATA:

- (1) diameter (inches) 4
- (2) total depth (feet) 120
- (3) static water level (feet) 6 below above top of ground.
- (4) casing STD, 40' (material) (depth)
4 (size) if telescope see back.
- (5) screen (length) (depth to top)
(size) (material)
- (6) pump 1/3 6 (HP) (yield gpm)
ED (type power)
- (7) electric log NO (yes or no)
(organization running log)
- (8) how well bottom plugged OPEN

CODED


DRILLERS REMARKS:

APR 30 1973

MISS. Bd. of
WATER COMMISSIONERS

If well telescopes please sketch and show depths.

GROUND LEVEL

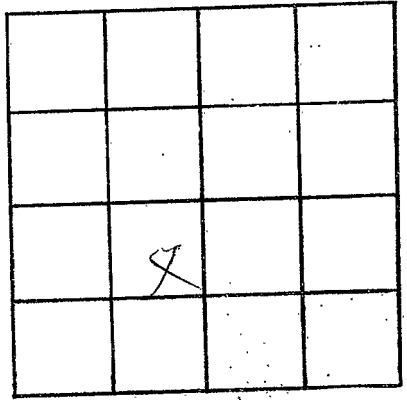

SECTION 11

Please indicate well location X.

ADDITIONAL INFORMATION

If more than one screen,
show locations of each on sketch.