

MacBride

LOWNDES
G 158
10-3-73

MISSISSIPPI
BOARD OF WATER COMMISSIONERS
416 North State Street
Jackson, Mississippi 39201

OCT 19 1973
CODEL

WATER WELL DRILLERS LOG

MISS. BD. OF
WATER COMM.

Oct 3 1973 CLOUDY Well + Pump
date well completed firm name county well located Lowndes

LANDOWNER: <u>Attney Morris</u>	description of formations encountered	from	to
<u>Hwy 22 W.</u> <u>Calumbe, Miss.</u> (mailing address)			
	<u>sand</u>	<u>0</u>	<u>25</u>
	<u>sandy blue clay</u>	<u>25</u>	<u>47</u>
	<u>blue clay</u>	<u>47</u>	<u>185</u>
	<u>sand</u>	<u>185</u>	<u>205</u>

WELL LOCATION:
sec. 30 T 19 N R 18 E
1 miles W of Cal
(distance) (direction) (nearest town)

WELL PURPOSE: home
(home, irrigation, municipal, industrial)

- WELL COMPLETION DATA:
- (1) diameter (inches) 4"
 - (2) total depth (feet) 205
 - (3) static water level (feet) 27 below ~~depth~~ top of ground.
 - (4) casing 4" Steel, 51',
(material) (depth)
 if telescope see back.
(size)
 - (5) screen 0,
(length) (depth to top)
 ,
(size) (material)
 - (6) pump 1 Sub, 10
(HP) (yield gpm)

(type power)
 - (7) electric log
(yes or no)


(organization running log)
 - (8) how well bottom plugged

CODED

DRILLERS REMARKS:

If well telescopes please sketch and show depths.

GROUND LEVEL

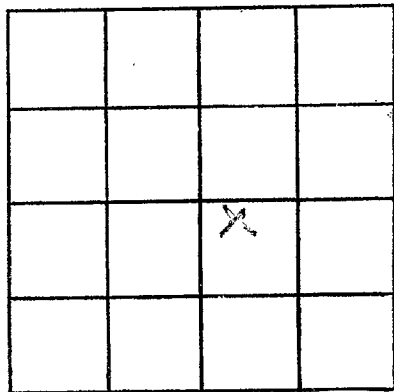

SECTION 30

Please indicate well location X.

ADDITIONAL INFORMATION

If more than one screen, show locations of each on sketch.