

**LOWNDES**  
 6154  
 8-24-73

MISSISSIPPI  
 BOARD OF WATER COMMISSIONERS  
 416 North State Street  
 Jackson, Mississippi 39201

CODED  
 OCT 19 1973

WATER WELL DRILLERS LOG

MISS. BD. OF  
 WATER COMMISSIONERS

Aug 24 1973 date well completed  
 13 Clabby Well + Pump Set firm name  
 Lowndes county well located

LANDOWNER: Bobby Bolton  
 Tuscaloosa Rd  
 (mailing address)

description of formations encountered	from	to
Clay	0	12
sand + gravel	12	32
sandy blue clay	32	42
blue clay	42	70
fine sand	70	80
blue clay	80	120
fine sand	120	130
sand	130	150

WELL LOCATION:  
 sec. 7 T 18 S R 18 E  
 2 miles E of Col.  
 (distance) (direction) (nearest town)

WELL PURPOSE: home  
 (home, irrigation, municipal, industrial)

WELL COMPLETION DATA:


(1) diameter (inches) 4"  
 (2) total depth (feet) 150  
 (3) static water level (feet) 8 below top of ground.  
 (4) casing 4" steel, 50 (material), (depth)  
 (size) if telescope see back.  
 (5) screen 0 (length), (depth to top)  
 (size), (material)  
 (6) pump (HP) (yield gpm)  
 (type power)  
 (7) electric log (yes or no)  
 (organization running log)  
 (8) how well bottom plugged

CODED

DRILLERS REMARKS: Owner installed own pump

If well telescopes please sketch and show depths.

GROUND LEVEL

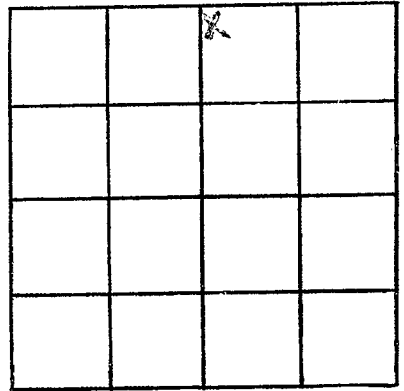

SECTION 7

Please indicate well location X.

ADDITIONAL INFORMATION

If more than one screen,  
show locations of each on sketch.