

LOWME'S
G 163
9/17/80

MISSISSIPPI
BOARD OF WATER COMMISSIONERS
416 North State Street
Jackson, Mississippi 39201

CODED

WATER WELL DRILLERS LOG

9/17/80 date well completed
Allsup Drilling, Inc. firm name
LOWME'S county well located

LANDOWNER: Hooker Chemicals
INC.
Nashville Ferry Rd.
Columbus, Ms. 39701
(mailing address)

WELL LOCATION:
sec 34 T 18 S R 18 E
1 miles S of Columbus
(distance) (direction) (nearest town)

WELL PURPOSE: INDUSTRIAL
(home, irrigation, municipal, industrial)

- WELL COMPLETION DATA:
- (1) diameter (inches) 4"
 - (2) total depth (feet) 235'
 - (3) static water level (feet) 40' below top of ground.
 - (4) casing PVC (material) 235' (depth)
4" x 2" if telescope see back.
(size)
 - (5) screen 80' (length) 155' (depth to top)
2" (size) PVC (material)
 - (6) pump 3/4 (HP) (yield gpm)
Electric (type power)
 - (7) electric log NO (yes or no)
- (organization running log)

(8) how well bottom plugged CAPPED

DRILLERS REMARKS:
No. 2 Well

description of formations encountered	from	to
<u>CLAY</u>	<u>0</u>	<u>8</u>
<u>GRAVEL BED</u>	<u>8</u>	<u>25</u>
<u>HARD BLE ROCK</u>	<u>25</u>	<u>75</u>
<u>1st SAND</u>	<u>75</u>	<u>110</u>
<u>HARD MUCK</u>	<u>110</u>	<u>155</u>
<u>WATER SAND</u>	<u>155</u>	<u>235</u>

CODED


DEPT. OF NATURAL RESOURCES
BUREAU OF LAND & WATER RESOURCES

AUG 3 1983

RECEIVED

If well telescopes please sketch and show depths.

GROUND LEVEL

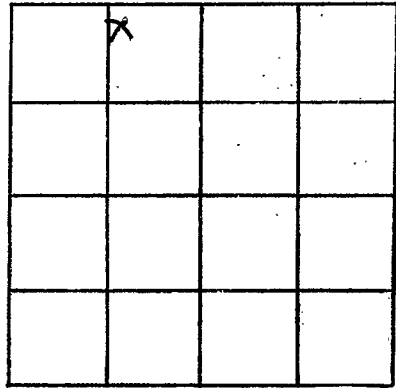

SECTION 34

Please indicate well location X.

ADDITIONAL INFORMATION

If more than one screen,
show locations of each on sketch.