

**LOWNDES**  
**G 168**  
**7-1-74**

MISSISSIPPI  
 BOARD OF WATER COMMISSIONERS  
 416 North State Street  
 Jackson, Mississippi 39201

**CODED**

**WATER WELL DRILLERS LOG**

July 1 1974 Clardy well + Pump Lowndes  
 date well completed firm name county well located

LANDOWNER: Tim Wright

Yorkville Rd.  
Columbus, Miss.  
 (mailing address)

WELL LOCATION:

sec 35 T 18 N S R 18 E  
2 miles S of Cal  
 (distance) (direction) (nearest town)

WELL PURPOSE: home  
 (home, irrigation, municipal, industrial)

WELL COMPLETION DATA:

- (1) diameter (inches) 4"
- (2) total depth (feet) 180
- (3) static water level (feet) 18 below above top of ground.
- (4) casing 4" steel, 60'  
 (material) (depth)  
         if telescope see back.  
 (size)
- (5) screen          (length) (depth to top)  
 (size) (material)
- (6) pump 1/2 Sub 12  
 (HP) (yield gpm)  
 (type power)
- (7) electric log           
 (yes or no)  
 (organization running log)
- (8) how well bottom plugged

description of formations encountered

	from	to
clay	0	8
sand + gravel	8	28
sandy blue clay	28	35
blue clay	35	90
sandy blue clay	90	100
Five sand	100	130
sandy blue clay	130	160
course sand	160	180

**CODED**


**RECORDED**  
**INDEXED**

JUL 22 1974

DRILLERS REMARKS:

If well telescopes please sketch and show depths.

GROUND LEVEL

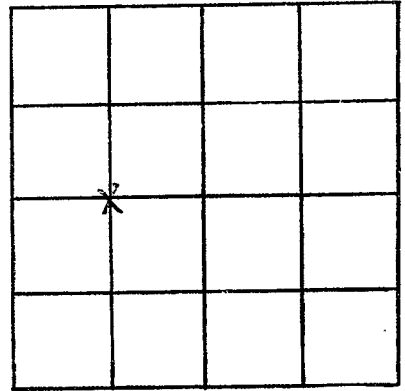

SECTION 35

Please indicate well location X.

ADDITIONAL INFORMATION

If more than one screen,  
show locations of each on sketch.