

LOWNDES
G 169
5-22-74

MISSISSIPPI
 BOARD OF WATER COMMISSIONERS
 416 North State Street
 Jackson, Mississippi 39201

CODED

WATER WELL DRILLERS LOG

May 22 1974 Clay well + pump Lowndes
 date well completed firm name county well located

LANDOWNER: (On unson)
 for Contractor
West + Sons.
Followed Rd.
Columbus, Miss.
 (mailing address)

WELL LOCATION:
 sec. 26 T 18 R 18
 $\frac{1}{2}$ miles SE of Col
 (distance) (direction) (nearest town)

WELL PURPOSE: home
 (home, irrigation, municipal, industrial)

WELL COMPLETION DATA:

- (1) diameter (inches) 4
- (2) total depth (feet) 170
- (3) static water level (feet) 12 below above top of ground.
- (4) casing 4" steel, 72'
 (material) (depth)
 _____ if telescope see back.
 (size)
- (5) screen _____
 (length) (depth to top)


 (size) (material)
- (6) pump $\frac{1}{2}$ Sub 12
 (HP) (yield gpm)

 (type power)
- (7) electric log _____
 (yes or no)

 (organization running log)
- (8) how well bottom plugged _____

description of fomations encountered	from	to
clay	0	8
sand + gravel	8	30
blue clay	30	38
sandy blue clay	38	53
blue clay	53	60
sandy blue clay	60	70
blue clay	70	120
sandy blue clay + fine sand	120	150
streaks coarse sand + clay	150	170

CODED

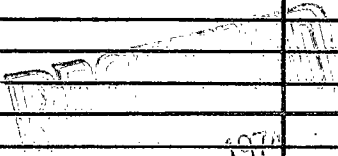


DRILLERS REMARKS:

JUN 4 1974

WATER COMMISSION

If well telescopes please sketch and show depths.

GROUND LEVEL

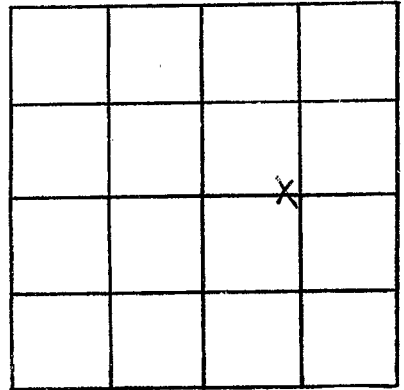

SECTION 26

Please indicate well location X.

ADDITIONAL INFORMATION

If more than one screen,
show locations of each on sketch.