

**LOWMEDES**  
~~G 2000~~  
 6-20-74

MISSISSIPPI  
 BOARD OF WATER COMMISSIONERS  
 170 ~~600~~ 416 North State Street  
 Jackson, Mississippi 39201

**CODED**

**WATER WELL DRILLERS LOG**

June 20 1974 Clardy well + pump Lowmedes  
 date well completed firm name county well located

LANDOWNER: Tommy Vice  
3503 Caellia Circle  
Columbus, Miss  
 (mailing address)

WELL LOCATION:  
 sec. 3 T 18 N R 18 E  
 S (W)  
1 miles NE of Col  
 (distance) (direction) (nearest town)

WELL PURPOSE: home  
 (home, irrigation, municipal, industrial)

WELL COMPLETION DATA:

(1) diameter (inches) 4 "

(2) total depth (feet) 305

(3) static water level (feet) 59 below above top of ground.

(4) casing 4" steel, 102,  
 (material) (depth)

\_\_\_\_\_ If telescope see back.  
 (size)

(5) screen \_\_\_\_\_, \_\_\_\_\_  
 (length) (depth to top)

\_\_\_\_\_ (size) \_\_\_\_\_ (material)

(6) pump 3/4 Sub 1.5  
 (HP) (yield gpm)

\_\_\_\_\_ (type power)

(7) electric log \_\_\_\_\_  
 (yes or no)

\_\_\_\_\_ (organization running log)

(8) how well bottom plugged \_\_\_\_\_

description of formations encountered	from	to
clay	0	25
brown sand	25	50
sandy blue clay	50	95
blue clay	95	140
fine sand + blue clay	140	150
blue clay	150	160
sandy blue clay	160	168
fine sand + blue clay	168	195
blue clay	195	240
fine sand	240	250
blue clay	250	285
course sand	285	305

**CODED**


**RECEIVED**

MAY 22 1974

DRILLERS REMARKS: \_\_\_\_\_

If well telescopes please sketch and show depths.

GROUND LEVEL

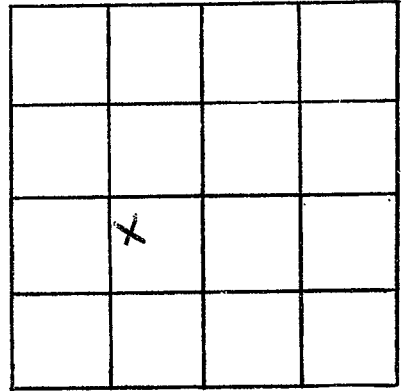

SECTION 6a

Please indicate well location X.

ADDITIONAL INFORMATION

If more than one screen, show locations of each on sketch.