

LOWNDES
G 122
8-8-74

MISSISSIPPI
BOARD OF WATER COMMISSIONERS
 416 North State Street
 Jackson, Mississippi 39201 **CODED**

WATER WELL DRILLERS LOG

8-8 1974 W. J. REEVES & SON LOWNDES
 date well completed firm name county well located

LANDOWNER: ED DOUGHTY
BOX 487
COLUMBUS
 (mailing address)

WELL LOCATION:
 sec. 34 T 18 R. 12 E
2 miles S of COLUMBUS
 (distance) (direction) (nearest town)

WELL PURPOSE: HOME
 (home, irrigation, municipal, industrial)

- WELL COMPLETION DATA:**
- (1) diameter (inches) 4
 - (2) total depth (feet) 180
 - (3) static water level (feet) 8 below above top of ground.
 - (4) casing ST2 40
 (material) (depth)
4 If telescope see back.
 (size)
 - (5) screen NONE
 (length) (depth to top)
 (size) (material)
 - (6) pump 1/2 10
 (HP) (yield gpm)
ELECT
 (type power)
 - (7) electric log NO
 (yes or no)
 (organization running log)
 - (8) how well bottom plugged OPEN

description of formations encountered	from	to
CLAY	0	12
SAND & GRAVEL	12	28
BLUE CLAY	28	33
" SAND	33	36
" CLAY	36	96
" SAND	96	108
" CLAY	108	126
" SAND	126	134
" CLAY	134	162
" SAND	162	180

CODED


DRILLERS REMARKS:
 OCT 24 1974

DRILLERS REMARKS:

MISS. BD. OF WATER COMM

If well telescopes please sketch and show depths.

GROUND LEVEL

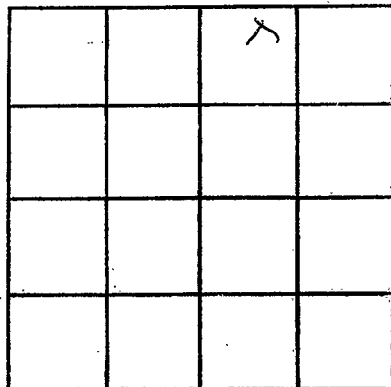

SECTION 34

Please indicate well location X.

ADDITIONAL INFORMATION

If more than one screen,
show locations of each on sketch.