

LOWMEES
G175
9-4-75

MISSISSIPPI
 BOARD OF WATER COMMISSIONERS
 416 North State Street
 Jackson, Mississippi 39201
WATER WELL DRILLERS LOG

CODED

Apr 4 1975 Claydy Well + Pump Lowmees
 date well completed firm name county well located

LANDOWNER: <u>Robert McRae</u>	description of formations encountered	from	to
<u>Deeva Dr</u>			
WELL LOCATION: sec. <u>12</u> T. <u>18</u> N R. <u>18</u> E S W <u>2</u> miles <u>E</u> of <u>Col</u> (distance) (direction) (nearest town)	<u>clay</u>	<u>0</u>	<u>6</u>
	<u>sand + gravel</u>	<u>6</u>	<u>22</u>
	<u>blue clay</u>	<u>22</u>	<u>30</u>
	<u>sandy blue clay</u>	<u>30</u>	<u>50</u>
	<u>blue clay</u>	<u>50</u>	<u>75</u>
	<u>streaks of sand + clay</u>	<u>75</u>	<u>90</u>
	<u>blue clay</u>	<u>90</u>	<u>125</u>
	<u>sandy blue clay</u>	<u>125</u>	<u>150</u>
	<u>sand</u>	<u>150</u>	<u>165</u>

WELL PURPOSE: home
 (home, irrigation, municipal, industrial)

WELL COMPLETION DATA:

- (1) diameter (inches) 4
- (2) total depth (feet) 165
- (3) static water level (feet) 10 below above top of ground.
- (4) casing steel, 58',
 (material) (depth)
 _____ if telescope see back.
 (size)
- (5) screen _____,
 (length) (depth to top)
 _____ (size) _____ (material)
- (6) pump 1/2 sub 15
 (HP) (yield gpm)
 _____ (type power)
- (7) electric log _____
 (yes or no)
 _____ (organization running log)
- (8) how well bottom plugged _____


RECEIVED

MAY - 7 1975

DRILLERS REMARKS: _____

If well telescopes please sketch and show depths.

GROUND LEVEL

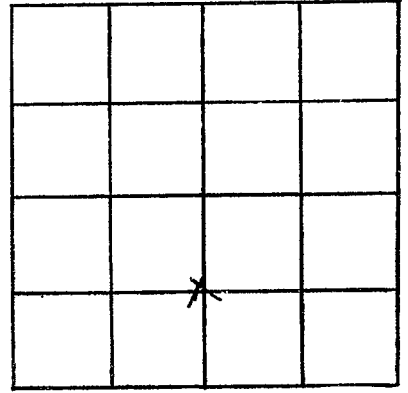

SECTION 12

Please indicate well location X.

ADDITIONAL INFORMATION

If more than one screen,
show locations of each on sketch.