

LOWNDES
G176
4-29-75

MISSISSIPPI
BOARD OF WATER COMMISSIONERS CODED
 416 North State Street
 Jackson, Mississippi 39201
WATER WELL DRILLERS LOG

Apr 24 1975 Clardy well + pump Lowndes
 date well completed firm name county well located

LANDOWNER: Jac. Houle
S. Lehmborg Rd
Columbus, Miss
 (mailing address)

WELL LOCATION:
 NE NW sec. 25 T 18 S R 18 E
3 miles SE of Col
 (distance) (direction) (nearest town)

description of formations encountered	from	to
clay	0	10
sand + gravel	10	22
blue clay	22	30
streaks of sand + clay	30	62
blue clay	62	110
streaks of sand + clay	110	130
clay	130	190
streaks of sand + clay	190	200

WELL PURPOSE: Cattle
 (home, irrigation, municipal, industrial)


WELL COMPLETION DATA:

- (1) diameter (inches) 4
- (2) total depth (feet) 200
- (3) static water level (feet) 8 below above top of ground.
- (4) casing steel, 65'
 (material) (depth)
 _____ if telescope see back.
 (size)
- (5) screen _____
 (length) (depth to top)

 (size) (material)
- (6) pump 1/2 sub 15
 (HP) (yield gpm)

 (type power)
- (7) electric log _____
 (yes or no)

 (organization running log)
- (8) how well bottom plugged _____

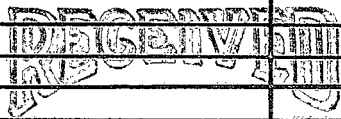


DRILLERS REMARKS: _____

MAY - 7 1975

If well telescopes please sketch and show depths.

GROUND LEVEL

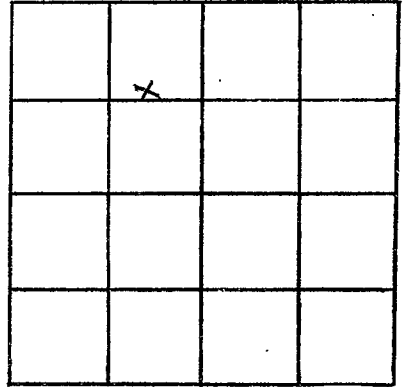

SECTION 25

Please indicate well location X.

ADDITIONAL INFORMATION

If more than one screen,
show locations of each on sketch.