

Lowndes  
G 177  
7-9-75

MISSISSIPPI  
 BOARD OF WATER COMMISSIONERS  
 416 North State Street  
 Jackson, Mississippi 39201

CODED

WATER WELL DRILLERS LOG

7-9 1975 Claywell Pump Lowndes  
 date well completed firm name county well located

LANDOWNER: R. W. Jolly  
(Sand Rd) waterworks  
Colombus, Miss.  
Road  
 (mailing address)

description of formations encountered	from	to
clay	0	5
sand + gravel	5	20
blue clay	20	35
sandy blue clay	35	60
blue clay	60	85
sandy blue clay	85	95
blue clay	95	115
sand	115	140

WELL LOCATION:  
 sec. 1 T 18 N R 18 E 13L  
S W  
2 miles NE of Col  
 (distance) (direction) (nearest town)

WELL PURPOSE: home  
 (home, irrigation, municipal, industrial)


- WELL COMPLETION DATA:
- (1) diameter (inches) 4"
  - (2) total depth (feet) 140
  - (3) static water level (feet) 10 below above top of ground.
  - (4) casing 4" steel 65'  
 (material) (depth)  
 \_\_\_\_\_ if telescope see back.  
 (size)
  - (5) screen \_\_\_\_\_  
 (length) (depth to top)  
 \_\_\_\_\_  
 (size) (material)
  - (6) pump 1/2 Sub 12  
 (HP) (yield gpm)  
 \_\_\_\_\_  
 (type power)
  - (7) electric log \_\_\_\_\_  
 (yes or no)  
 \_\_\_\_\_  
 (organization running log)
  - (8) how well bottom plugged \_\_\_\_\_

DRILLERS REMARKS: \_\_\_\_\_

REGISTERED  
 AUG 11 1975

If well telescopes please sketch and show depths.

GROUND LEVEL

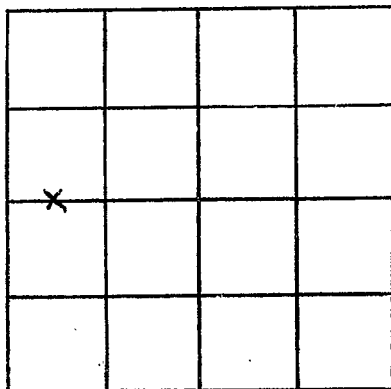

SECTION 1

Please indicate well location X.

ADDITIONAL INFORMATION

If more than one screen,  
show locations of each on sketch.