

Lowndes

6179

MISSISSIPPI  
 BOARD OF WATER COMMISSIONERS  
 416 North State Street  
 Jackson, Mississippi 39201

WATER WELL DRILLERS LOG

date well completed 19\_\_\_\_ firm name \_\_\_\_\_ county well located \_\_\_\_\_

LANDOWNER: \_\_\_\_\_

description of formations encountered

from to

(mailing address)

WELL LOCATION:

sec. \_\_\_\_\_ T \_\_\_\_\_ N \_\_\_\_\_ R \_\_\_\_\_ E \_\_\_\_\_  
S \_\_\_\_\_ W \_\_\_\_\_

\_\_\_\_\_ miles \_\_\_\_\_ of \_\_\_\_\_  
(distance) (direction) (nearest town)

WELL PURPOSE:  
(home, irrigation, municipal, industrial)

WELL COMPLETION DATA:

- (1) diameter (inches) 6 x 3
- (2) total depth (feet) \_\_\_\_\_
- (3) static water level (feet) \_\_\_\_\_ below above  
top of ground.
- (4) casing \_\_\_\_\_ (material) \_\_\_\_\_ (depth) \_\_\_\_\_  
\_\_\_\_\_ if telescope see back.  
(size)
- (5) screen \_\_\_\_\_ (length) \_\_\_\_\_ (depth to top) \_\_\_\_\_  
\_\_\_\_\_ (size) \_\_\_\_\_ (material)
- (6) pump \_\_\_\_\_ (HP) \_\_\_\_\_ (yield gpm) \_\_\_\_\_  
\_\_\_\_\_ (type power)
- (7) electric log \_\_\_\_\_ (yes or no) \_\_\_\_\_  
\_\_\_\_\_ (organization running log)
- (8) how well bottom plugged \_\_\_\_\_

*Well #1  
 Sample over  
 599*


**RECEIVED**

SEP 10 1976

DRILLERS REMARKS: \_\_\_\_\_

④

If well telescopes please sketch and show depths.

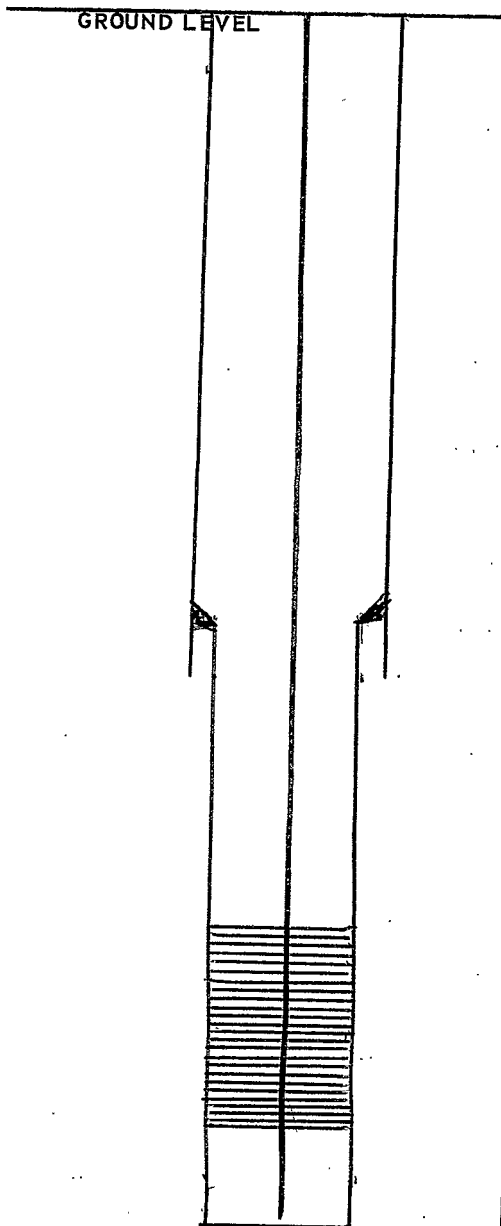

If more than one screen, show locations of each on sketch.

WELL # 1

SAMPLE # 2  
(DEEP)

X			

SECTION 11

Please indicate well location X.

ADDITIONAL INFORMATION

167 CPM  
 12.31 DD  
 9.12 GPF  
 +18 W.L.

3" BLANK PIPE

779 TOP OF SCREEN

84' SCREEN 3" .015

951 BOTTOM