

LOWNDES

6180

5176

MISSISSIPPI BOARD OF WATER COMMISSIONERS
416 North State Street
Jackson, Mississippi 39201

CODED

TEST

WATER WELL DRILLERS LOG

Well No. 2

May

1976

Herndon Well & Supply, Inc.

Lowndes

date well completed

firm name

county well located

LANDOWNER:

City of Columbus

Columbus, MS

(mailing address)

WELL LOCATION:

sec. 21 T 18 S R 18 E

(Inside) Second St. Columbus

(distance) miles (direction) of (nearest town)

WELL PURPOSE: Munic. Testing
(home, irrigation, municipal, industrial)

WELL COMPLETION DATA:

(1) diameter (inches) 6 x 3

(2) total depth (feet) 586

(3) static water level (feet) 43 below above top of ground.

(4) casing (material) (depth)

(size) If telescope see back.

(5) screen (length) (depth to top)

(size) (material)

(6) pump (HP) (yield gpm)

(type power)

(7) electric log (yes or no)

(organization running log)

(8) how well bottom plugged

description of formations encountered

from

to

Pink Clay - Sandy

0

8

White Sand and Gravel

8

22

Sandy Gray Clay

22

270

Good Sand

270

280

White Chalk

280

300

Blue Clay

300

335

Sand

335

356

Blue Clay

356

376

Sand

376

400

Blue Clay

400

470

Pink Clay

470

495

Sand and Gravel

495

570

Blue Clay

570

586

RECEIVED
SEP 10 1976

DRILLERS REMARKS:


MISS. BD. OF WATER COMMISSIONERS

⊕

If well telescopes please sketch and show depths.

WELL #2
SAMPLE #3

GROUND LEVEL

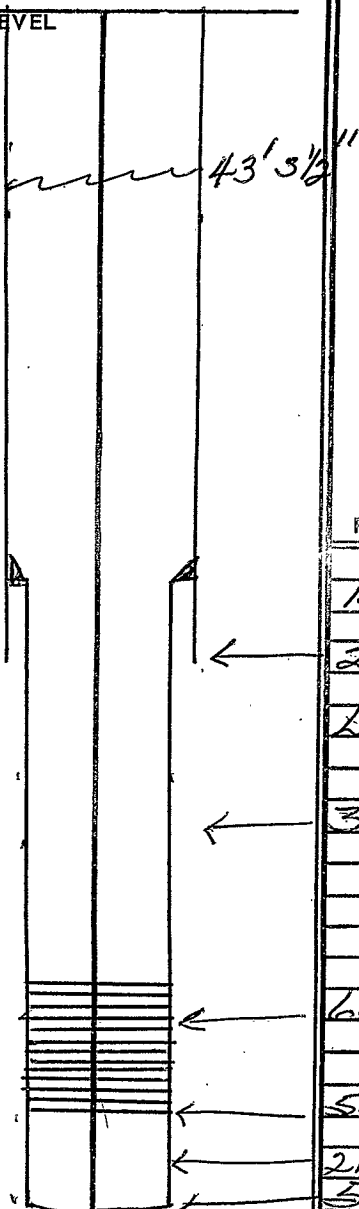

+			

SECTION 21

Please indicate well location X.

ADDITIONAL INFORMATION

157 G.P.M.

← 231' 6" CASING

LEAD SEAL 195'

← 315 BLANK 3"

← 63' .015 SCREEN 3"

← 564' BOTTOM SCREEN

← 21' BLANK

← 586' BOTTOM WELL

If more than one screen, show locations of each on sketch.