

**LOWNDES**  
**G181**  
**676**

MISSISSIPPI  
 BOARD OF WATER COMMISSIONERS  
 416 North State Street  
 Jackson, Mississippi 39201


WATER WELL DRILLERS LOG

Well No. 4



June 1976 Herndon Well & Supply, Inc. Lowndes  
 date well completed firm name county well located

LANDOWNER:	description of formations encountered	from	to
City of Columbus	Brown Sand	0	5
Columbus, MS	Brown Clay	5	13
(mailing address)	Red Sand & Gravel	13	19
WELL LOCATION:	Blue Clay (Strkd Sand)	19	165
sec. 29 T. 19 N. R. 18 E. S. Wk	Sand	165	180
Inside Columbus	Blue Clay	180	185
(distance) miles (direction) of (nearest town)	Sand	185	202
WELL PURPOSE: Municipal Test	Blue Clay (Small Rock @ 209)	202	248
(home, irrigation, municipal, industrial)	Sand	248	262
WELL COMPLETION DATA:	Chalk (Lt Gray)	262	325
(1) diameter (inches) 6 x 3	Sand	325	376
(2) total depth (feet) 588	Gray Clay	376	430
(3) static water level (feet) 24 below top of ground.	Pink Clay	430	457
(4) casing Steel 268	Sand	457	475
(material) (depth)	Clay	475	498
6" (size) if telescope see back.	Sand	498	580
(5) screen 42 504	Clay	580	588
(length) (depth to top)			
3 SS			
(size) (material)			
(6) pump (HP) (yield gpm)			
(type power)			
(7) electric log (yes or no)			
(organization running log)			
(8) how well bottom plugged			

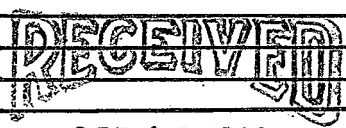

SEP 10 1976

DRILLERS REMARKS:


MISS. BO. OF WATER COMMISSIONERS



If well telescopes please sketch and show depths.

Test well # 4

GROUND LEVEL

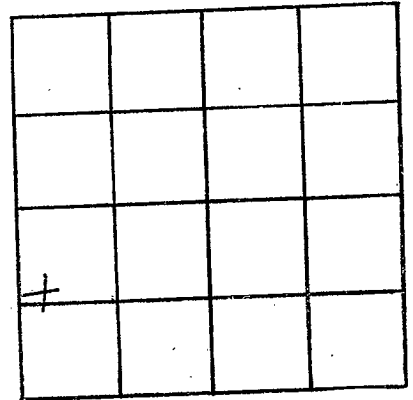

SECTION 29

Please indicate well location X.

ADDITIONAL INFORMATION

250 LEAD SEAL  
268' 6"

252' 3'

504'

42'

546'

42' 3"

588 BOTTOM OF WELL

If more than one screen, show locations of each on sketch.

