

LOWNDES

~~BOAKLY~~ G 183

7-18-75

MISSISSIPPI BOARD OF WATER COMMISSIONERS

416 North State Street

Jackson, Mississippi 39201

WATER WELL DRILLERS LOG

7-18- date well completed

1975 W.J. REEVES & SON firm name

LOWNDES county well located

LANDOWNER: J. H. SAMS M.D.

719 7th ST. No.

COLUMBUS (mailing address)

WELL LOCATION:

NW 1/4 sec. 16 T. 18 N. R. 18 E. 0 miles (distance) of COLUMBUS (direction) (nearest town)

WELL PURPOSE: IRRIGATION (home, irrigation, municipal, industrial)

WELL COMPLETION DATA:

- (1) diameter (inches) 4
(2) total depth (feet) 409
(3) static water level (feet) 90 below top of ground.
(4) casing PVC, 369 (material) (depth)
(5) screen 40, 369 (length) (depth to top)
(6) pump 5 (HP) 60 (yield gpm)
(7) electric log NO (yes or no)

(organization running log)

(8) how well bottom plugged SAND

DRILLERS REMARKS:

description of formations encountered

from to


Table with 3 columns: description of formations encountered, from, to. Rows include CLAY (0-18), SANDY BLUE CLAY (18-210), BLUE SAND (210-255), CLAY (255-288), SAND (288-310), CLAY (310-350), WHITE SAND (350-405), BLUE CLAY (405-409).

RECORDED NOV 28 1975

MISS. Bd. of Water Comm.

If well telescopes please sketch and show depths.

GROUND LEVEL

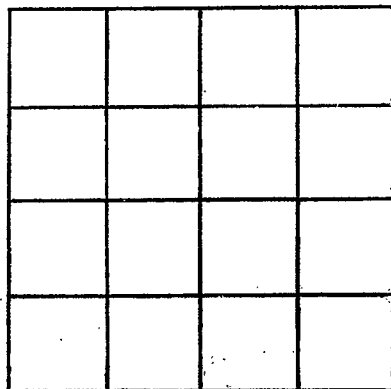

SECTION _____

Please indicate well location X.

ADDITIONAL INFORMATION

If more than one screen,
show locations of each on sketch.