

LOWNDES
G184
8177
ELY #72

MISSISSIPPI
BOARD OF WATER COMMISSIONERS
416 North State Street
Jackson, Mississippi 39201
WATER WELL DRILLERS LOG

CODED

August 1977 Herndon Well & Supply, Inc Lowndes
date well completed firm name county well located

LANDOWNER: City of Columbus

description of formations encountered

from to

Columbus, Mississippi

Surface 0 30

Well No. 2

Gumbo and Streaked Sand 30 90

(mailing address)

Gumbo 90 110

WELL LOCATION:

Gumbo and Streaked Sand 120 150

sec. 11 T. 18 N. R. 18 E. S. W.

Gumbo and Sand 150 240

Inside miles of Columbus
(distance) (direction) (nearest town)

Gumbo 240 300

WELL PURPOSE: Municipal
(home, irrigation, municipal, industrial)

Blue and Pink Gumbo 300 330

WELL COMPLETION DATA:

Gumbo 330 390

Pink Gumbo 390 420

Gumbo 420 438

Sand and Shale 438 450

Sand 450 495

Pink Gumbo CODED 495 510

Gumbo 510 650

Sand 650 660

Streaked Sand and Gumbo 660 690

Gumbo 690 780

Chert 780 810

Sand 810 830

Gumbo 830 840

Sand/White 840 890

Streaked Sand and Gumbo 890 920

(1) diameter (inches) 18 x 12

(2) total depth (feet) 895 ft.

(3) static water level (feet) +14.58 below top of ground.

(4) casing Steel, 782' (material), (depth)

18" (size) If telescope see back.

(5) screen 100' (length), 795' (depth to top)

12" (size), Stainless Steel (material)

(6) pump 40 (HP), 1455 (yield gpm)

Electric (type power)

(7) electric log yes (yes or no)

USGS (organization running log)

(8) how well bottom plugged 12" BWV

DRILLERS REMARKS:


DEC 28 1977

MISS. Bd. OF WATER COMM.

(X)

If well telescopes please sketch and show depths.

GROUND LEVEL

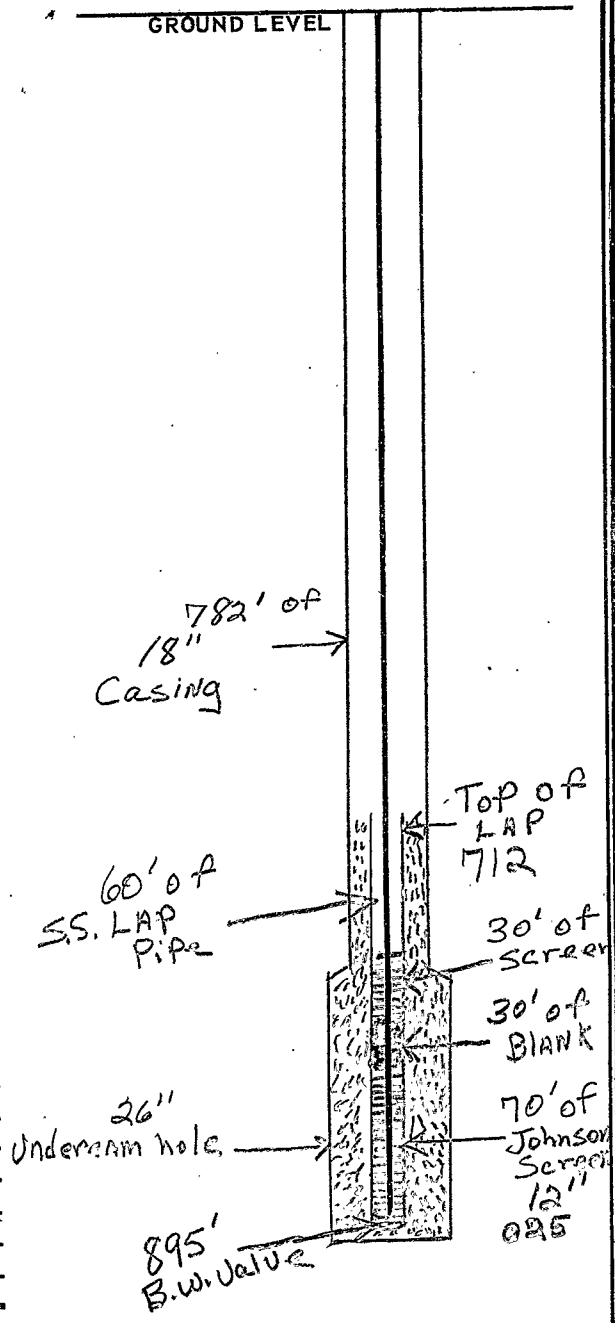

X			

SECTION //

Please indicate well location X.

ADDITIONAL INFORMATION

Additional information section with horizontal lines for text entry.

If more than one screen, show locations of each on sketch.