

MISSISSIPPI DEPARTMENT OF NATURAL RESOURCES

Bureau of Land and Water Resources


Southport Mall

P.O. Box 10631

Jackson, Mississippi 39209

WATER WELL DRILLERS LOG

Gumer Drilling Service, Inc.

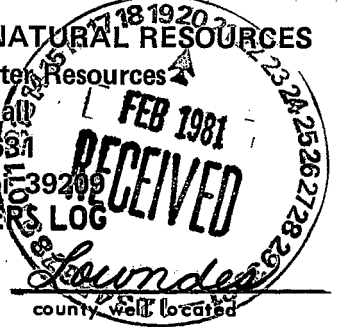

LOWLANDS
 C 163 C 188
 1/15/81

B. B. Dabney
 CODED

date well completed

firm name

county well located

LANDOWNER:

Patrick Petroleum
 205 Highland Village
 Jackson, Ms. 39211
 (mailing address)

description of formations encountered

from

to

clay + gravel 0 35
 clay, rock, sand 35 400

WELL LOCATION: 500' N + 2000' W

#1 sec. 34 - 18 N R. 18 E SE 1/4
 Williamson
 distance miles Columbus
 (direction) (nearest town)

WELL PURPOSE: oil field
 (home, irrigation, municipal, industrial)

WELL COMPLETION DATA:

- (1) diameter (inches) 3"
- (2) total depth (feet) 400'
- (3) static water level (feet) 75' (below above top of ground)
- (4) casing steel 284'
 (material) (depth)
 3" (size) if telescope see back.
- (5) screen open ended
 (length) (depth to top)
 (size) (material)
- (6) pump 75
 (HP) (yield gpm)
 ac (type power)
- (7) electric log ac
 (yes or no)
 (organization running log)

(8) how well bottom plugged
 none
 peel

DRILLERS REMARKS:


DEPT. OF NATURAL RESOURCES
 BUREAU OF LAND & WATER RESOURCES

FEB 20 1981

RECEIVED

If well telescopes please
sketch and show depths.

GROUND LEVEL

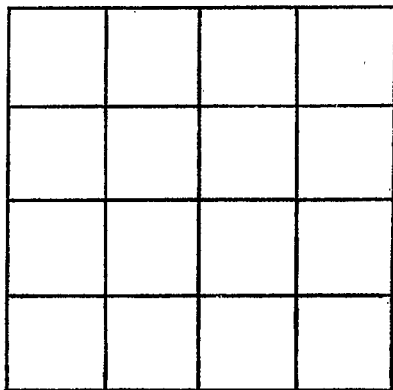

SECTION _____

Please indicate well location X.

ADDITIONAL INFORMATION

If more than one screen,
show locations of each on sketch.