

LOWNDES
 6762 193
 9/8/80

MISSISSIPPI
 BOARD OF WATER COMMISSIONERS
 416 North State Street
 Jackson, Mississippi 39201

CE-110

WATER WELL DRILLERS LOG

9/8 1980 AlkSup Drilling Inc. LOWNDES
 date well completed firm name county well located

LANDOWNER: Hooker Chemical
Nashville Ferry Rd.
Columbus, MS. 39701
 (mailing address)

description of formations encountered	from	to
CLAY	0	8
GRAVEL BED	8	25
HARD BLUE ROCK	25	75
1st SAND	75	110
HARD MUCK	110	155
WATER SAND	155	235

WELL LOCATION:
 sec 34 T 18 N R 18 E
1 miles S of Columbus
 (distance) (direction) (nearest town)

WELL PURPOSE: INDUSTRIAL
 (home, irrigation, municipal, industrial)

WELL COMPLETION DATA:

(1) diameter (inches) 4"

(2) total depth (feet) 235'

(3) static water level (feet) 40' above top of ground

(4) casing PVC, 235'
 (material) (depth)

4" x 2" if telescope see back
 (size) 155'

(5) screen 80', 235'
 (length) (depth to top)

2", PVC
 (size) (material)

(6) pump 3/4, 2.5
 (HP) (yield gpm)

Electric
 (type power)

(7) electric log No
 (yes or no)

(organization running log)

(8) how well bottom plugged capped

CE-110

DEPT. OF NATURAL RESOURCES
 BUREAU OF LAND & WATER RESOURCES


AUG 3 1983

RECEIVED

DRILLERS REMARKS:
No Well

If well telescopes please sketch and show depths.

GROUND LEVEL

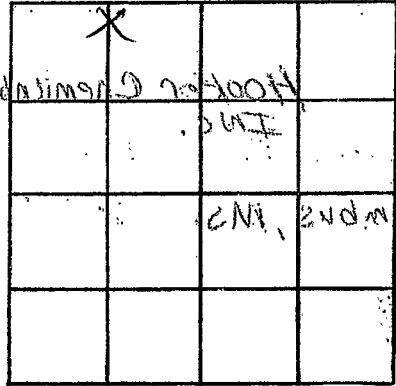

SECTION 34

Please indicate well location X.

ADDITIONAL INFORMATION

If more than one screen, show locations of each on sketch.