

LOWNDES
G195

MISSISSIPPI DEPARTMENT OF NATURAL RESOURCES
Bureau of Land and Water Resources
Southport Mall
P.O. Box 10631
Jackson, Mississippi 39209
WATER WELL DRILLERS LOG

CODED

March 29 19 84 Allsup Drilling, Inc. Lowndes
date well completed firm name county well located

LANDOWNER: City of Columbus
Columbus-Lowndes Emergenc
Operations Center
P O Box 1408
Columbus, MS 39701
(mailing address)

description of formations encountered	from	to
Sand & Gravel	0'	80'
Tough Muck	80'	120'
Sand	120'	293'

WELL LOCATION:
sec. 16 T 18 R 18 W
City Courthouse
(Heart of city) of Columbus
(distance) miles (direction) (nearest town)

WELL PURPOSE: Municipal
(home, irrigation, municipal, industrial)

CODED

WELL COMPLETION DATA:

- (1) diameter (inches) 4"
- (2) total depth (feet) 293'
- (3) static water level (feet) 50' below above top of ground.
- (4) casing PVC, 293'
(material) (depth)
4" x 2" if telescope see back.
(size)
- (5) screen 40', 253'
(length) (depth to top)
2" PVC
(size) (material)
- (6) pump 1 1000 GPM
(HP) (yield gpm)
Electric
(type power)
- (7) electric log No
(yes or no)

(organization running log)

(8) how well bottom plugged capped

DRILLERS REMARKS:

DEPT. OF NATURAL RESOURCES
BUREAU OF LAND & WATER RESOURCES

JUN 21 1984

RECEIVED


If well telescopes please sketch and show depths.

GROUND LEVEL

120' - 4" casing

135' - 2" casing

40' - 2" screen

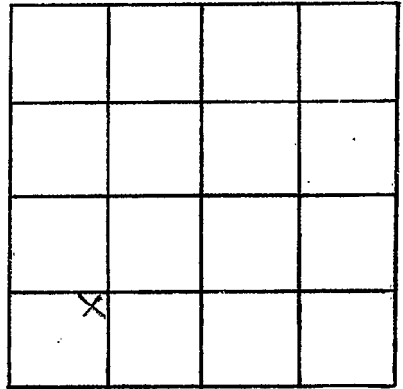

SECTION 16

Please indicate well location X.

ADDITIONAL INFORMATION

If more than one screen, show locations of each on sketch.