

MISSISSIPPI DEPARTMENT OF NATURAL RESOURCES

Bureau of Land and Water Resources

Southport Mall

P.O. Box 10631

Jackson, Mississippi 39209

WATER WELL DRILLERS LOG

CODED

G 198  
Lowndes

2-20-85 19 Clardy Well Drilling Lowndes  
date well completed firm name county well located

LANDOWNER: A.P.A.C.  
Lake Norris Rd.  
Columbus, MS  
(mailing address)

WELL LOCATION:  
sec. 28 T. 18 N. R. 18 E.  
S W  
1 miles So of Col  
(distance) (direction) (nearest town)

WELL PURPOSE: Industrial  
(home, irrigation, municipal, industrial)

- WELL COMPLETION DATA:
- (1) diameter (inches) 4"
  - (2) total depth (feet) 328'
  - (3) static water level (feet) 18' below above top of ground.
  - (4) casing Pvc, 91'  
(material) (depth)  
4"  
(size) if telescope see back.
  - (5) screen 37'  
(length) (depth to top)  
2" Pvc  
(size) (material)
  - (6) pump 1" 1300gph  
(HP) (yield gpm)  
elec  
(type power)
  - (7) electric log No  
(yes or no)

(organization running log)

(8) how well bottom plugged

DRILLERS REMARKS:

description of formations encountered	from	to
red clay	0	6
sand & gravel	6	51
blue clay	51	58 1/2
rock	58 1/2	60
blue clay	60	75 1/2
rock 6"		
good clay	75	108
sandy clay	108	116
good clay	116	141
sandy clay	141	148
good sand	148	153
sandy clay	153	190
rock	170	170 1/2
sandy clay	170 1/2	173
rock	173	173 1/2
sandy clay	173 1/2	175 1/2
rock 3"		
sandy clay	17 1/2	177 1/2
rock 3"		
sandy clay	172 1/2	179
rock 3"		
sandy clay	179	193
good sand	193	328

RECEIVED  
APR 2 - 1985

Department of Natural Resources  
Bureau of Land & Water Resources


If well telescopes please sketch and show depths.

GROUND LEVEL

41' 4"

11' 2"

30' sand screen

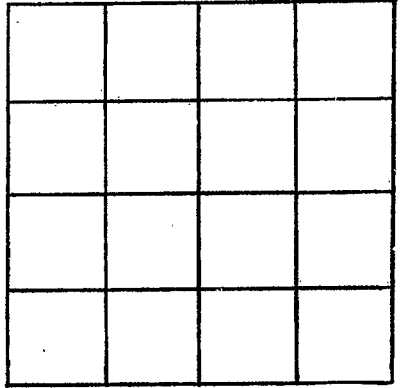

SECTION \_\_\_\_\_

Please indicate well location X.

ADDITIONAL INFORMATION

If more than one screen, show locations of each on sketch.