	State W	ell Report			
a I ormdon	Part 1		For Office Use Only:		
County: Lowndes 654	-	t of Environmental Quality	Aquifer:		
Permit #:	3	nd Water Resources	Well #: C + 4T 87		
Driller: David C. Brown	i i	Sox 10631			
Date drilling completed; 9/27/04	•	IS 39289-0631 961-5210	L. S. Elevation: Co 240		
mil-South Millia Con	Le. (601)35	4-6938 (fax)	B-log #:		
mil-South Drilling Eorgany, Inc. (601)354-6938 (fax)  B-log #:					
State Law requires that this report be prepared by the driller in detail and filed with the Department within					
30 days of completion of drilling Well Owner Informs		Wel	Location		
Tom Roberts	anon				
Owner Name	% - p^. )	Latitude: 35 • 31 • 3/	" Longitude: 38 • 35 · 54 "		
Mailing Address: 2620 Canterberry Road Method of Lat/Long (circle one): Conventional Survey,					
		USGS quad, Hand-held	GPS, Survey-grade GPS		
_Co1umbus	MS 39705	5W 4 5W 4 Sec 8	Twn 175 Rng 18W		
City St:	ate Zip Code	1 '4	185		
Telephone No. (662) 327-2867		Distance Direction Miles	Nearest Town of in Columbus near		
Totaphone Tro.		wines	Golden Tiangle Hospital		
	Well 1	Data			
Purpose of Well (circle one) Home Inc	instrial Public Supply	(Irrigation) Fish Culture	Other:		
<del>-</del>					
Date well drilling started: 9/27/04	Date	well drilling completed: 9/2	7704		
If flowing, method of flow regulation: Va	lveOther (d	lescribe)			
Static Water Level: 11 feet a	bove or below (circle one)	and surface Date measured:	9-27-04		
Method of Measurement (circle one) steel tape electric tape air line other:					
Hole depth: 34 Well de	nth. 34	_ Well grouted to a depth of _	17 6		
	<i>ր</i> ա	wen grouter to a debut of _	teet		
Type of grout (circle one): Cement	Bentonite Mix				
Casing length: 29 feet Casi	ing diameter:4	inches Type of casing: _	PVC		
Screen length: 5 feet Scr	een diameter: 4	inches Type of screen: _	PVC		
Screen slot size: .032 inches	Setting depth: From_		34feet		
Type of completion (circle all applicable): Gravel packed Underreamed Telescoped Open hole Natural Development					
Other (describe):					
Top of lap pipe or reduction in casing:feet. If telescoped or more than one screen, describe on back of page					
Logs run (circle all applicable) No log run Electric Gamma Ray Density Sonic Neutron Other:					
Name of organization running log(s):		•	1		

I certify that the well was drilled, constructed, and completed in accordance with all applicable requirements of the Mississippi

Department of Environmental Quality and/or the Mississippi Department of Health regulations and state laws.

Lic. #654

David C. Brown

Print Name of Water Well Contractor and License No.

RECEIVED OCT 13 2004 BY: OLWR


Signature of Water Well Contractor

If well telescopes please sketch below and show depths.

Ground Level	C+41
. •	

Description of Formations Encountered	From	To
clay	0	18
sand	18	29
sand & fine gravel	29	34
	1	1
	1	1
	1	1
	<del></del>	

If more than one screen, show location of each on sketch

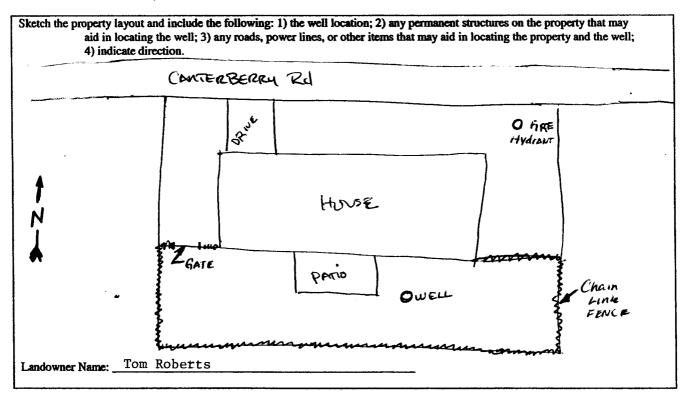

Signature of Water Well Contractor

RECEIVED

OCT 13 2004

BY: OLWR

## STATE WELL REPORT

## Part 2

County Lowndes **Pump Installer's Completion Report** Mississippi Department of Environmental Quality 654 Permit #: Office of Land and Water Resources P.O. Box 10631 Driller: David C. Brown Jackson, MS 39289-0631 Date completed: 9/27/04(601)961-5210 (601)354-6938 (fax)

For Office Use Only:			
Aquifer: 6240			
Well #:	•		
Elevation:			

This report should be prepared by the pump installer in detail and filed with the Department within 30 days of the installation of pump.				
Well Owner Information	Well Location			
Owner Name: Tom Roberts	Latitude:Longitude:			
Mailing Address: 2620 Canterberry Road	Method of Lat/Long (circle one): Conventional Survey,			
	USGS quad Hand-held GPS, Survey-grade GPS			
ColumbusMS39705CityStateZip Code	SW 4 SW 4 Sec 9 Twn 178 Rng 18W  Distance Direction Nearest Town			
Telephone No. ( 662) 327-2867	Miles of in Columbus near Golden Triangle Hospital			
Pump Type Circle one	Power Type Circle one			
Air Lift Submersible	Diesel Engine Gasoline Engine Natural Gas			
Bucket Piston Turbine	Electric Motor Hand Tractor PTO			
Centrifugal Rotary Flowing Well	Windmill Other (specify):			
Other (specify):	Horse Power Rating of Motor: 3/4			
Date Pump Installed: 9/27/04	Setting Depth: 28 feet			
Rated Pump Capacity: 1() Gallons Per Minute	Number of Stages:1			
Pump Test Data	Method of Measuring Water Level Circle one			
Date Well Tested: 9/27/04  Static Water Level (A): 11 Feet Below Land Surface  Pumping Water Level (B): 20 Feet Below Land Surface	Air Line Electric Measuring Line Steel Tape  Other (specify):			
Drawdown [(B) – (A)]:9 Feet Below Land Surface	For flowing well, measured shut in head:feet			
Test Pumping Rate:10Gallons Per Minute	Well yielded GPM with a drawdown of			
Duration of Pump Test (minimum 4 hours): 4 hours	feet afterhours of pumping			
I HEREBY CERTIFY that the above statements are true to the best of my knowledge.  David C. Brown Lic. #654				

Print Name of Pump Installer and License No. (if applicable) Signature of Pump Installer

**RECEIVED** 

OCT 13 2004

BY: OLWR