

STATE WELL REPORT

Part 1

Driller's Log

Mississippi Department of Environmental Quality
Office of Land and Water Resources
P.O. Box 2309
Jackson, MS 39225-2309
(601)961-5210
(601)360-0535 (fax)

County: Howard
 Permit #: _____
 Driller: Clardy Drill
 Date drilling completed: 10/30/13

For Office Use Only:

Well #: G241
 Aquifer: _____
 E-Log #: _____

State Law requires that this report be prepared by the license holder responsible for the work and filed with the Department at the above address within 30 days of completion of drilling of the well or borehole.

Well Owner Information <small>(Landowner if borehole is not for a water well)</small>	Well or Borehole Location
Owner Name: <u>Robert Raymond</u>	Latitude: <u>N 33° 30.638</u> Longitude: <u>W 88° 25.100</u>
Mailing Address: <u>1305 Military Rd. Columbus, GA 39701</u>	Method of Lat/Long (check one): Conventional Survey _____, USGS quad _____, Hand-held GPS <input checked="" type="checkbox"/> , Survey-grade GPS _____
City _____ State _____ Zip Code <u>39701</u>	<u>SE 1/4 SE 1/4, Sec. 9 T 18S R 18W</u>
Telephone No. <u>(601) 549-1133</u>	<u>Inside City limits of Columbus</u> (Distance) _____ (Direction) _____ (Nearest Town) _____

Well / Borehole Data

Date drilling started: 10/29/13 Date drilling completed: 10/30/13 Hole depth: 206 Hole diameter: 4"

Location of the source of any surface water used for drilling: _____

Method of dosing and volume of Chlorine used in drilling and development: _____

Logs run (circle all applicable): No log run Electric Gamma Ray Density Sonic Neutron Other: _____

Name of organization running log(s): _____

Purpose of borehole (circle one): Water Well Geotechnical/Geological Investigation Ground Source Heat Pump Seismic Survey Other (describe) _____

If drilling is not related to water well construction, skip the remainder of this block

Purpose of Well (circle all applicable): Home Industrial Public Supply Irrigation Fish Culture

Other (describe): _____

If a flowing well, method of flow regulation: Valve _____ Other (describe) _____

Static Water Level: 43' feet [above or below] land surface Date measured: 10/30/13
(circle one)

Method of measurement (circle one): Steel tape Electric tape Air line Other (describe): _____

Well depth: 206 Well grouted to a depth of: 20 feet Type of grout (circle one): Neat Cement Bentonite Mix

Casing length: 120' feet Casing diameter: 4 inches Type of casing: PVC

Screen length: _____ feet Screen diameter: _____ inches Type of screen: _____

Screen slot size: _____ inches Setting depth: From _____ feet to _____ feet

Type of completion (circle all applicable): Gravel packed Underreamed Open hole Natural Development

Other (describe): _____

Top of lap pipe or reduction in casing: _____ feet

RECEIVED
NOV 26 2013
BY: OLWR


If telescoped or more than one screen, describe on next page

County: Howard
 Permit #: _____

For Office Use Only:
 Well #: 6241

The sketch below only required for water wells

If well telescopes, show depths on sketch.

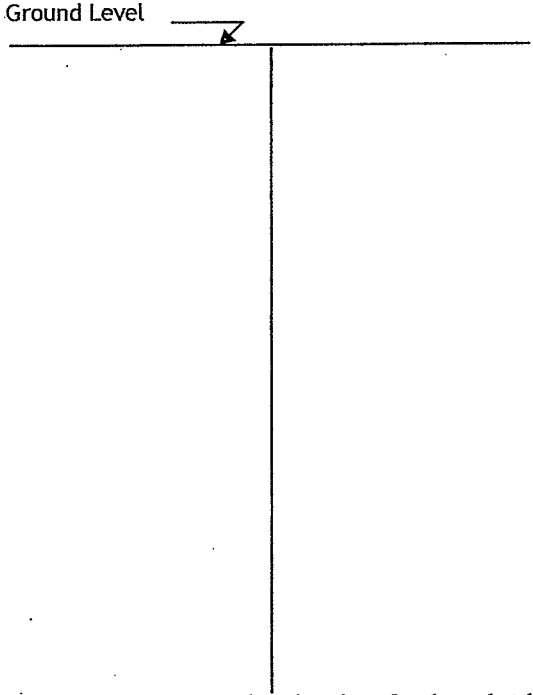


Description of formations encountered must be provided for all wells and boreholes, unless specifically exempted by regulations

Description of Formations Encountered	From (depth)	To (depth)
Brown clay	Ground level	12
Sandy blue clay	12	91
Clay	91	99
Sandy clay	99	111
Rocky sand streak	111	151
Clay	151	166
Sand	166	191
Clay	191	192
Sand streak	192	198
Clay	198	205
	205	206

If more than one screen, show location of each on sketch

Sketch the property layout and include the following:

- 1) the well location
- 2) any permanent structures on the property that may aid in locating the well
- 3) any roads, power lines, or other items that may aid in locating the property and the well
- 4) north arrow

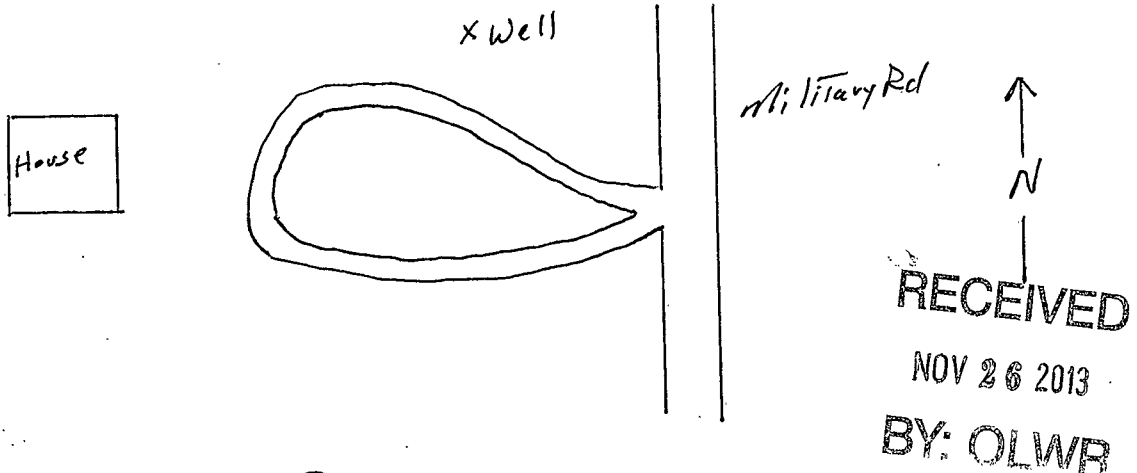

Landowner Name: Robert Raymond

I HEREBY CERTIFY that the well/borehole was drilled, constructed, and completed in accordance with all applicable requirements of the Mississippi Department of Environmental Quality and the Mississippi Department of Health regulations, if applicable, and state laws.

UNR00000496
Donald B. Clardy 11/25/13 Donald B. Clardy
 Print Name of Responsible Licensee and License No. | Date | Signature of Licensee

The first part of the document discusses the importance of maintaining accurate records of all transactions. It emphasizes that every entry should be supported by a valid receipt or invoice. This ensures transparency and allows for easy verification of the data.

In the second section, the author details the various methods used to collect and analyze the data. This includes both manual and automated processes. The goal is to ensure that the information gathered is both reliable and comprehensive.

The third part of the document focuses on the results of the analysis. It shows that there are significant trends in the data, particularly in the areas of sales and customer behavior. These findings are crucial for making informed business decisions.

Finally, the document concludes with a series of recommendations for future work. It suggests that further research should be conducted to explore the underlying causes of the observed trends. This will help the organization to better understand its market and improve its performance.

The following table provides a summary of the key findings from the analysis. It shows the percentage change in sales over the period and the correlation between customer satisfaction and repeat purchases.

Metric	Value
Sales Growth (%)	15.2
Customer Satisfaction Score	4.5/5.0
Repeat Purchase Rate	28%

These results indicate a strong positive correlation between customer satisfaction and repeat purchases, which is a key indicator of long-term business success.