

G

4-13-61

WATER WELL DRILLERS LOG

G-322

Date: 4-13, 1961, Driller: W. J. REEVES & SON County: LOWNDES  
13557 (Name)

(1) Owner of Land: ROBBIE WILSON (Name)

OLDBURY RD., COLUMBUS (Address)

(2) Location: 1/4, 1/4, Sec. 34 T.18R.6W

3 miles EAST, of COLUMBUS (distance), (direction), (Nearest Town)

(3) Topography: LEVEL (Hilly), (Flat), (Level)

(4) Purpose of Well: DOMESTIC (Domestic Irrigation, Municipal, Industrial, Other)

Description & Color of Materials Sand, Clay, Red Clay, Shell, etc.	Thick- ness Feet	Depth Feet
RED CLAY	17	0
SAND & GRAVEL	18	17
BLUE CLAY	73	35
" SAND	13	108
" CLAY	4	121
" SAND	10	125

Information upon completion of well:

(1) Diameter 4 inches.

(2) Total Depth 135 feet.

(3) Water Level 18 feet below top of ground.

(4) Cased to 37', Size 4"

(5) Screen: Size —, Length —


(6) Were any formations sealed against pollution?

yes, no.

If YES depth of formation

Why

Drillers Remarks:

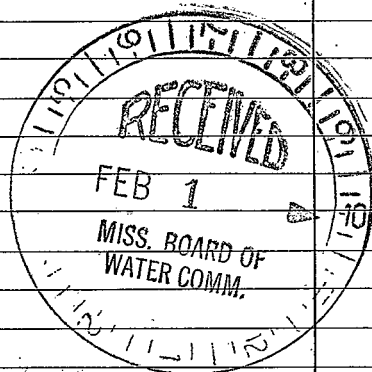

(Use Back Side)

Well No.

