

LOWNDES

MISSISSIPPI BOARD OF WATER COMMISSIONERS

G 1001
One info to locate
7-6-61

WATER WELL DRILLERS LOG

7
L-24

Date: 7-6-61, 19, Driller: Layne-Central Co. County Lowndes

(Name)

(1) Owner of Land: Hooker Chemical Co.
(Name)
Columbus, Mississippi
(Address)

(2) Location: NW 1/4, SE 1/4, Sec. 10 T 19S R 18
W miles, of Columbus
(distance) (direction) (Nearest Town)

(3) Topography: _____
(Hilly) (Flat) (Level)

(4) Purpose of Well: Industrial
(Domestic Irrigation
Municipal, Industrial, Other)

Description & Color of Materials Sand, Clay, Red Clay, Shell, etc.	Thick- ness Feet	Depth Feet
Clay	0	12
Sand & gravel	12	31
Clay	31	40
Sand	40	46
Hard shale	46	86
Sandy shale	86	190
Hard shale	190	220
Sandy shale	220	270
Hard shale	270	304
Sandy shale	304	351
Hard clay	351	454
Fine sand	454	486
Hard clay	486	506
Sand gravel	506	597
Hard clay	597	670
Sand	670	690
Hard gumbo	690	811
Sandy clay	811	829
Rock	829	831
Clay	831	845
Sand & gravel	845	914
Iron up gravel	914	919
Sand & gravel	919	946
Rock	946	948
Sand & gravel	948	965
Rock	965	966
Gravel & boulders	966	978
Rock	978	983
Gravel & sand-boulders	983	995

Information upon completion of well:

(1) Diameter 28" inches.

(2) Total Depth 975 feet.

(3) Water Level 440' 1" feet below top of ground.


(4) Cased to 910', Size 16"

(5) Screen: Size 10", Length 60"

(6) Were any formations sealed against pollution?
x yes, _____ no.

If YES depth of formation 910'
Why Required

Drillers Remarks: _____

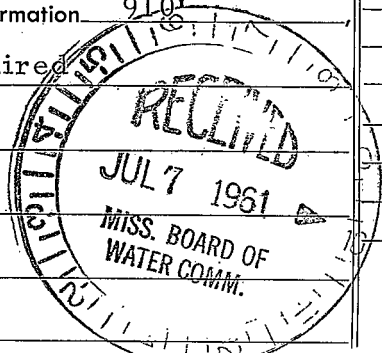

(Use Back Side)

Well No.

17