

**MISSISSIPPI  
BOARD OF WATER COMMISSIONERS**  
416 North State Street  
Jackson, Mississippi 39201

**WATER WELL DRILLERS LOG**

Lowndes  
G 2002  
3-67

3-13 1967 W.J. REEVES & SON LOWNDES  
date well completed firm name county well located

LANDOWNER: J.B. FIELDS  
TUSCALOOSA RD.  
DOWDLE

description of formations encountered	from	to
	<u>SANDY SOIL</u>	<u>0</u>
<u>CLAY</u>	<u>3</u>	<u>11</u>
<u>SAND &amp; GRAVEL</u>	<u>11</u>	<u>27</u>
<u>BLUE CLAY</u>	<u>27</u>	<u>30</u>
<u>" SAND</u>	<u>30</u>	<u>32</u>
<u>" CLAY</u>	<u>32</u>	<u>79</u>
<u>" SAND</u>	<u>79</u>	<u>105</u>

COLUMBUS  
(mailing address)


WELL LOCATION:  
sec. 11 T 18 <sup>th</sup> R 18 <sup>th</sup> S W  
1 miles NE of COLUMBUS  
(distance) (direction) (nearest town)

WELL PURPOSE: HOME  
(home, irrigation, municipal, industrial)

**WELL COMPLETION DATA:**


- (1) diameter (inches) 4
- (2) total depth (feet) 105
- (3) static water level (feet) 9 below above top of ground.
- (4) casing STEEL, 36 1/2,  
(material) (depth)  
         if telescope see back.  
(size)
- (5) screen NONE  
(length) (depth to top)  
         (size) (material)
- (6) pump 1/3 6  
(HP) (yield gpm)  
ELECT  
(type power)
- (7) electric log NO  
(yes or no)  
         (organization running log)
- (8) how well bottom plugged OPEN

DRILLERS REMARKS:

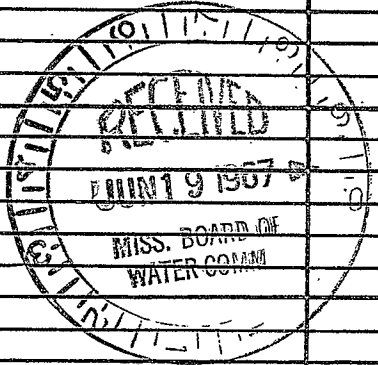

If well telescopes please sketch and show depths.

GROUND LEVEL

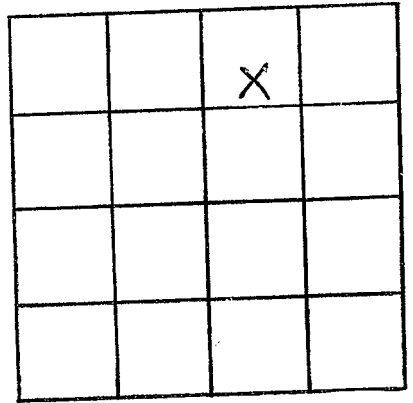

SECTION 11

Please indicate well location X.

ADDITIONAL INFORMATION

Lined area for additional information.

If more than one screen, show locations of each on sketch.