

LOWNDES
 2004
 11-30-73

MISSISSIPPI
 BOARD OF WATER COMMISSIONERS
 No. 2000
 per Boukley
 16 North State Street
 Jackson, Mississippi 39201

CODED

WATER WELL DRILLERS LOG

Nov 30 1973 Clardy Well + Pump Lowndes
 date well completed firm name county well located

LANDOWNER: H. Guise
 Waverly Rd
 Columbus, Miss
 (mailing address)

description of formations encountered	from	to
clay	0	10
sand + gravel	10	35
blue sand	35	50
blue clay	50	120
sandy blue clay	120	170
blue clay	170	215
sand + streaks of clay	215	240

WELL LOCATION:
 sec. 17 T18 N R18 E
 (S) (W)
 1 miles N of Cal
 (distance) (direction) (nearest town)

WELL PURPOSE:
 (home, irrigation, municipal, industrial)

WELL COMPLETION DATA:

(1) diameter (inches) 4

(2) total depth (feet) 240

(3) static water level (feet) 14 below above top of ground.

(4) casing steel, 55, (material) (depth)
 (size) If telescope see back.

(5) screen 0, (length) (depth to top)
 (size) (material)

(6) pump (HP) (yield gpm)
 (type power)

(7) electric log (yes or no)
 (organization running log)

(8) how well bottom plugged

CODED


DRILLERS REMARKS: Customer installs own pump

DEC 26 1973

MISS. Bd. of WATER COMMISSIONERS

If well telescopes please sketch and show depths.

GROUND LEVEL

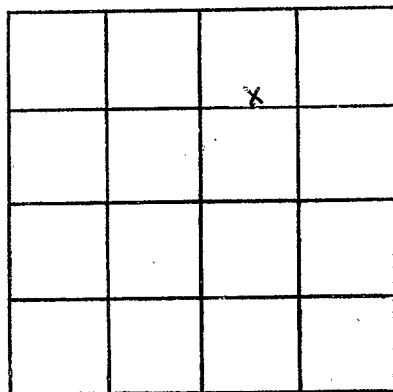

SECTION 17

Please indicate well location X.

ADDITIONAL INFORMATION

If more than one screen, show locations of each on sketch.