

Audubette

LOWNIDES

2005

126-73

No Code
Board

MISSISSIPPI
BOARD OF WATER COMMISSIONERS
416 North State Street
Jackson, Mississippi 39201

CODED

WATER WELL DRILLERS LOG

Dec 6

1973

Clardy Well + Pump

Lowndes

date well completed

firm name

county well located

LANDOWNER: Vertis Lee

Hy 69 S

Columbus, Miss
(mailing address)

description of formations encountered

from

to

clay

0

10

sand + gravel

10

25

blue clay

25

28

fine sand + soft clay

28

70

blue clay

70

120

sandy blue clay

120


140

sand

140

155

NW WELL LOCATION:

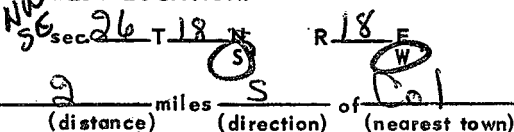

WELL PURPOSE: home
(home, irrigation, municipal, industrial)

WELL COMPLETION DATA:

- (1) diameter (inches) 4
- (2) total depth (feet) 155
- (3) static water level (feet) 9 below above top of ground.
- (4) casing steel, 75',
(material) (depth)
 if telescope see back.
(size)
- (5) screen ,
(length) (depth to top)
 ,
(size) (material)
- (6) pump 1/2 sub, 12
(HP) (yield gpm)

(type power)
- (7) electric log
(yes or no)

(organization running log)
- (8) how well bottom plugged

CODED

DEC 26 1973


DRILLERS REMARKS:

MISS. DEPT. OF
AGRICULTURE
WATER CONTROL

If well telescopes please sketch and show depths.

GROUND LEVEL

1000000

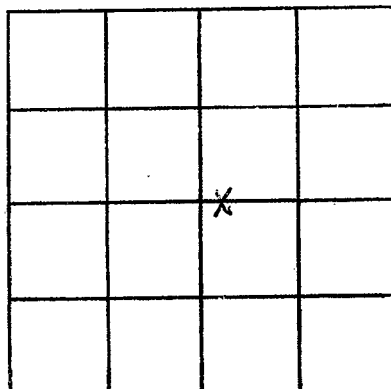

SECTION 26

Please indicate well location X.

ADDITIONAL INFORMATION

If more than one screen,
show locations of each on sketch.