

LOWNDES

G 2006

4-10-73

MISSISSIPPI

BOARD OF WATER COMMISSIONERS

Volceda
pub Block

416 North State Street
Mississippi 39201

CODED

WATER WELL DRILLERS LOG

Apr 10

19

73 Clardy well pump service Lowndes

date well completed

firm name

county well located

LANDOWNER: *Multi-Purpose Mfg.*

description of formations encountered

from

to

Highway 82 west

sand

0

10

Columbus, Miss

sand + gravel

10

28

(mailing address)

shale rock + sandy clay

28

47

blue clay

47

110

WELL LOCATION:

rocks + sandy clay

110

115

sec. *30* T *19* N

R *18* E

blue clay

115

145

1/2 miles *W* of *Columbus*

Five sand

145

160

(distance)

(direction)

(nearest town)

blue clay

160

180

course sand

180

200

WELL PURPOSE:

ind.

(home, irrigation, municipal, industrial)

WELL COMPLETION DATA:

(1) diameter (inches) 4

(2) total depth (feet) 200

(3) static water level (feet) 20 below top of ground.

(4) casing 4" steel (material), 53' (depth)

if telescope see back. (size)

(5) screen (length) (depth to top)

(size) (material)

(6) pump (HP) (yield gpm)

(type power)

(7) electric log (yes or no)

(organization running log)

(8) how well bottom plugged


CODED

DRILLERS REMARKS: *customer installed own pump*

APR 14 1973

If well telescopes please sketch and show depths.

GROUND LEVEL

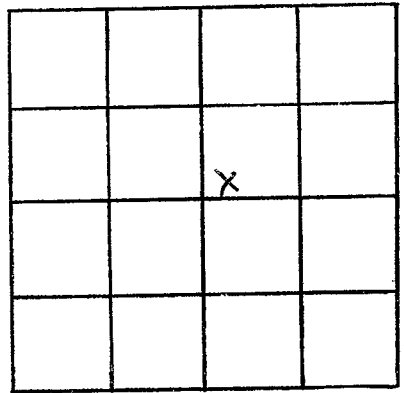

SECTION _____

Please indicate well location X.

ADDITIONAL INFORMATION

If more than one screen,
show locations of each on sketch.