

CODED

LOWNDES
2007
4-15-74

MISSISSIPPI
BOARD OF WATER COMMISSIONERS
416 North State Street
Jackson, Mississippi 39201
WATER WELL DRILLERS LOG

Apr 15 1974 Clardy Well + Pump Serv. Lounis
date well completed firm name county well located

LANDOWNER: Mr. Tom Christian
Nashville Ferry Rd
Columbus, Miss
(mailing address)

description of formations encountered	from	to
clay	0	10
sand + gravel	10	35
blue clay	35	38
sandy blue clay	38	53
blue clay	53	120
sandy blue clay	120	150
fine sand	150	160
course sand, rocks, clay	160	180

WELL LOCATION:
sec 34 T 18 N R 18 E
S W
2 miles S of Col
(distance) (direction) (nearest town)

WELL PURPOSE: home
(home, irrigation, municipal, industrial)

- WELL COMPLETION DATA:
- (1) diameter (inches) 4
 - (2) total depth (feet) 180
 - (3) static water level (feet) 18 below above top of ground.
 - (4) casing 4" steel, 55'
(material) (depth)
 - _____ if telescope see back.
(size)
 - (5) screen _____
(length) (depth to top)
 - _____ (size) _____ (material)
 - (6) pump _____ (HP) _____ (yield gpm)
 - _____ (type power)
 - (7) electric log _____ (yes or no)
 - _____ (organization running log)
 - (8) how well bottom plugged _____


CODED

DRILLERS REMARKS:
Customer installed own pump

MISS. Bd. of WATER COMMISSIONERS
APR - 1 1974

If well telescopes please sketch and show depths.

GROUND LEVEL

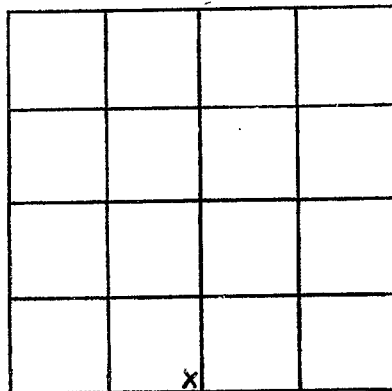

SECTION 34

Please indicate well location X.

ADDITIONAL INFORMATION

If more than one screen, show locations of each on sketch.