

LOWNDES
 2008
 5-29-74

McCabe
per McCabe

MISSISSIPPI
 BOARD OF WATER COMMISSIONERS
 416 North State Street
 Jackson, Mississippi 39201

CODED

WATER WELL DRILLERS LOG

May 29 1974 *Clary Well Pumpers* *Lowndes*
 date well completed firm name county well located

LANDOWNER: *Steve Lickerham*
Deena Drive
Columbus, Miss
 (mailing address)

description of formations encountered	from	to
clay	0	4
sand + gravel	4	30
sandy blue clay	30	50
blue clay	50	90
sandy blue clay	90	120
blue clay	120	145
sandy blue clay	145	170
sand	170	185

WELL LOCATION:
 sec. *12* T. *18* N. R. *18* E.
 S. W.
1 miles *E* of *Col*
 (distance) (direction) (nearest town)

WELL PURPOSE: *home*
 (home, irrigation, municipal, industrial)

WELL COMPLETION DATA:

(1) diameter (inches) *4"*

(2) total depth (feet) *185*

(3) static water level (feet) *10* below above-top of ground.

(4) casing *4" steel*, *55*,
 (material) (depth)
 (size) if telescope see back.

(5) screen _____ (length) (depth to top)
 (size) (material)

(6) pump *1/2 Sub* *12*
 (HP) (yield gpm)
 (type power)

(7) electric log _____ (yes or no)
 (organization running log)

(8) how well bottom plugged _____


CODED

MISS. Bd. OF WATER COMMISSIONERS

DRILLERS REMARKS:

If well telescopes please sketch and show depths.

GROUND LEVEL

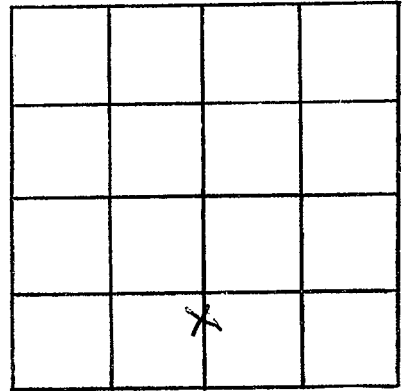

SECTION 12

Please indicate well location X.

ADDITIONAL INFORMATION

If more than one screen, show locations of each on sketch.