

Lowndes
G 2009
9-11-75

MISSISSIPPI
 BOARD OF WATER COMMISSIONERS
 416 North State Street
 Jackson, Mississippi 39201

WATER WELL DRILLERS LOG

9-11 1975 W. J. REEVES & SON LOWNDES
 date well completed firm name county well located

LANDOWNER: COLUMBUS
FAIR & LIVESTOCK ASSN.
COLUMBUS
 (mailing address)

WELL LOCATION:
 sec 14 T 18 N R 14 E
 (S) (W)
0 miles (distance) of COLUMBUS (nearest town)

description of formations encountered	from	to
CLAY	0	9
SAND	9	17
BLUE CLAY	17	68
" SAND	68	84
" CLAY	84	132
" SAND	132	160

WELL PURPOSE:
 (home, irrigation, municipal, industrial)

WELL COMPLETION DATA:

(1) diameter (inches) 4

(2) total depth (feet) 160

(3) static water level (feet) 18 below top of ground.

(4) casing STL 21
 (material) (depth)
4 if telescope see back.
 (size)

(5) screen NONE
 (length) (depth to top)
 (size) (material)

(6) pump 1/2 10
 (HP) (yield gpm)
FDCT
 (type power)

(7) electric log No
 (yes or no)


(organization running log)

(8) how well bottom plugged OPEN

DRILLERS REMARKS:

If well telescopes please
sketch and show depths.

GROUND LEVEL

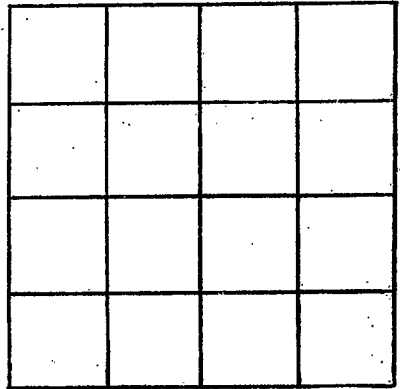

SECTION _____

Please indicate well location X.

ADDITIONAL INFORMATION

If more than one screen,
show locations of each on sketch.