

LOWNDES
 2010
 10/18/76

MISSISSIPPI
 BOARD OF WATER COMMISSIONERS
 416 North State Street
 Jackson, Mississippi 39201

WATER WELL DRILLERS LOG

Oct. 18 1976 ALLsup Drilling INC Lowndes
 date well completed firm name county well located

LANDOWNER: Muti Purpose
 Manufacturing Company
 Highway 82 W
 Columbus, MS. 39701
 (mailing address)

description of fomations encountered	from	to
SAND	0	3
CLAY-CLAY MIX	3	40
GRAVEL-CLAY MIX	40	98
GRAVEL	98	104
ROCK	104	126
SAND	126	138
MUCK	138	141
SAND	141	225

WELL LOCATION:

sec. 29, 18S R 18 W
 1/2 mile West of Columbus
 (distance) (direction) (nearest town)

WELL PURPOSE: none
 (home, irrigation, municipal, industrial)

WELL COMPLETION DATA:

- (1) diameter (inches) 4" X 2"
- (2) total depth (feet) 225'
- (3) static water level (feet) 27' below top of ground.
- (4) casing 4" plastic, 90' (material) (depth)
 4" X 2" if telescope see back. (size)
- (5) screen 80' length, 145' depth to top
 4" X 2" plastic (size) (material)
- (6) pump 9 (HP), 9 (yield gpm)
 Electric (type power)
- (7) electric log NO (yes or no)

(organization running log)
 (8) how well bottom plugged CAP

DRILLERS REMARKS:

RECEIVED
 JUL 19 1976
 MISS. Bd. OF WATER COMMISSIONERS


If well telescopes please sketch and show depths.

GROUND LEVEL

90' 4"
Casing

70' 0"
Casing

30' 0"
Commercial
Screen

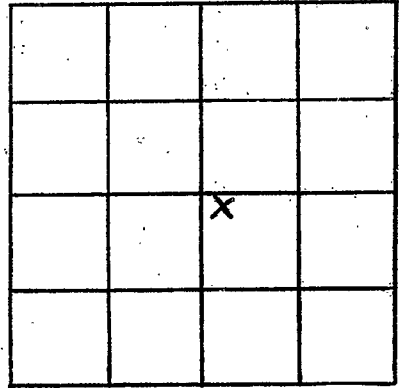

SECTION 30

Please indicate well location X.

ADDITIONAL INFORMATION

If more than one screen, show locations of each on sketch.