

LOWNDES
G 2017
10/28/76

MISSISSIPPI
 BOARD OF WATER COMMISSIONERS
 416 North State Street
 Jackson, Mississippi 39201

WATER WELL DRILLERS LOG

10-28 1976 Mid South Drilling LowNdes
 date well completed firm name county well located

LANDOWNER: Mid South Drilling
Jimmy L. South
Columbus Miss.
 (mailing address)

description of formations encountered	from to	
SAND + GRAVEL	0	39
CLAY	39	48
SAND	48	62
CLAY	62	91
SAND	91	110
CLAY	110	133
SAND	133	165
CLAY + Rock Strunks	165	185

WELL LOCATION:
 \sqrt sec 35 T18 N18 E
 \sqrt S18 W
2 miles South of Columbus
 (distance) (direction) (nearest town)

WELL PURPOSE: home
 (home, irrigation, municipal, industrial)


WELL COMPLETION DATA:
 (1) diameter (inches) 4
 (2) total depth (feet) 185
 (3) static water level (feet) 20 below/above top of ground.
 (4) casing PVC 82'
 (material) (depth)
 (size) if telescope see back.

(5) screen _____
 (length) (depth to top)
 (size) (material)
 (6) pump 1/4 10
 (HP) (yield gpm)
Electric
 (type power)

(7) electric log no
 (yes or no)
 (organization running log)

(8) how well bottom plugged OPEN


DRILLERS REMARKS:

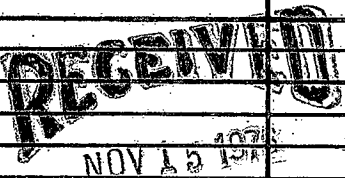

MISS. BD. OF WATER COMMISSIONERS

If well telescopes please sketch and show depths.

GROUND LEVEL

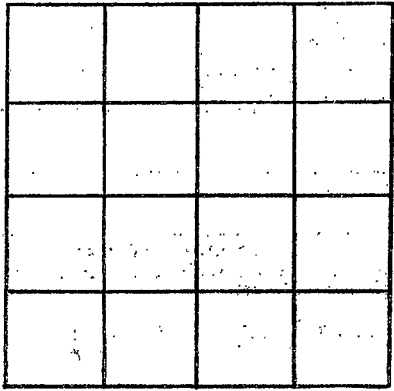

SECTION _____

Please indicate well location. X

ADDITIONAL INFORMATION

If more than one screen, show locations of each on sketch.