

LOWNDES
G 2014
4-15-77

MISSISSIPPI
 BOARD OF WATER COMMISSIONERS
 416 North State Street
 Jackson, Mississippi 39201

13L

WATER WELL DRILLERS LOG

4-15 19 77 date well completed
Columbus Handle Co. firm name
Lowndes county well located

LANDOWNER: Mrs. Winter
Columbus Miss
Columbus Handle Co.
 (mailing address)

description of formations encountered	from	to
<u>surf clay</u>	<u>0</u>	<u>3</u>
<u>blue clay</u>	<u>3</u>	<u>24</u>
<u>blue clay</u>	<u>24</u>	<u>258</u>
<u>sand</u>	<u>338</u>	<u>262</u>

WELL LOCATION:
 sec. 15 T. 18 R. 18
1/4 miles N of Columbus
 (distance) (direction) (nearest town)

WELL PURPOSE: Industrial
 (home, irrigation, municipal, industrial)

- WELL COMPLETION DATA:
- (1) diameter (inches) 4"
 - (2) total depth (feet) 262
 - (3) static water level (feet) 40 below top of ground.
 - (4) casing PVC, 95
 (material) (depth)
4 if telescope see back.
 (size)
 - (5) screen 0,
 (length) (depth to top)
 (size) (material)
 - (6) pump 3/4, 18
 (HP) (yield gpm)
0
 (type power)
 - (7) electric log _____
 (yes or no)
 (organization running log)
 - (8) how well bottom plugged open


RECEIVED
 JUN 18 1977

DRILLERS REMARKS:

MISSISSIPPI BOARD OF WATER COMMISSIONERS

If well telescopes please sketch and show depths.

GROUND LEVEL

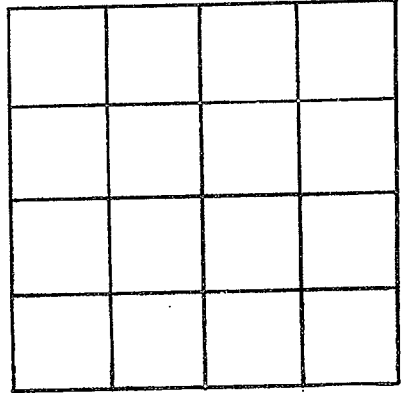

SECTION _____

Please indicate well location X.

ADDITIONAL INFORMATION

If more than one screen, show locations of each on sketch.