

MISSISSIPPI
BOARD OF WATER COMMISSIONERS
416 North State Street
Jackson, Mississippi 39201

WATER WELL DRILLERS LOG

LOWNDES
G 2015
5-18-77

13L

5-18 1977 Mid South Drilling Lowndes
date well completed firm name county well located

LANDOWNER: James Lee
Rt 8 - Box 83
Columbus, Miss. 39701
(mailing address)

WELL LOCATION:
sec. 35 T. 18 N. R. 18 E.
2 miles S of Columbus
(distance) (direction) (nearest town)

description of formations encountered	from	to
<u>surf.</u>	<u>0</u>	<u>8</u>
<u>brawl</u>	<u>8</u>	<u>18</u>
<u>blue clay</u>	<u>18</u>	<u>80</u>
<u>hard strata</u>	<u>80</u>	<u>165</u>

WELL PURPOSE: Home
(home, irrigation, municipal, industrial)

WELL COMPLETION DATA:

(1) diameter (inches) 4"

(2) total depth (feet) 165'

(3) static water level (feet) 40 below/above top of ground.

(4) casing PVC, 165'
(material) (depth)
 if telescope see back.
(size)

(5) screen None
(length) (depth to top)
 (size) (material)

(6) pump 1/2 10
(HP) (yield gpm)
EC
(type power)

(7) electric log
(yes or no)
 (organization running log)


(8) how well bottom plugged open

DRILLERS REMARKS:

RECEIVED
JUN 7 1977
MISS. BD. OF WATER COMMISSIONERS

If well telescopes please sketch and show depths.

GROUND LEVEL

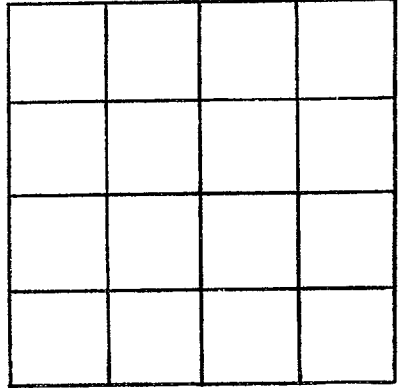

SECTION _____

Please indicate well location X.

ADDITIONAL INFORMATION

A series of horizontal lines for entering additional information, starting below the 'ADDITIONAL INFORMATION' header and extending to the bottom of the page.

If more than one screen, show locations of each on sketch.