

LOWNDES
G 206
9-14-77

**MISSISSIPPI
BOARD OF WATER COMMISSIONERS**
416 North State Street
Jackson, Mississippi 39201

WATER WELL DRILLERS LOG

Sept. 14 1977 ALL SUP Drilling Inc Lowndes
 date well completed firm name county well located

LANDOWNER: Mr. Richard Doughty
 P.O. Box 294
 Columbus Ms. 39701
 (mailing address)

description of formations encountered	from	to
Top Soil	0	3'
Clay	3'	13'
Red Sand + Gravel	13'	52'
lime rock	52'	118'
Muck	118'	119'
2nd SAND	119'	300'
rock		

WELL LOCATION:
 sec. 35 T 18 N R 18 E S
 3 miles E of Columbus
 (distance) (direction) (nearest town)

WELL PURPOSE: home
 (home, irrigation, municipal, industrial)

- WELL COMPLETION DATA:
- (1) diameter (inches) 4" X 2"
 - (2) total depth (feet) 300'
 - (3) static water level (feet) 46' below top of ground.
 - (4) casing 4" plastic 100' (material) (depth)
 4" X 2" (size) if telescope see back.
 - (5) screen 80' 220' (length) (depth to top)
 4" X 2" plastic (size) (material)
 - (6) pump 1/2 9 (HP) (yield gpm)
 Electric (type power)
 - (7) electric log NO (yes or no)
 - (8) how well bottom plugged CAP

DRILLERS REMARKS:


RECEIVED
 DEC - 1 1978

MISS. BD. OF WATER COMMISSIONERS

If well telescopes please sketch and show depths.

GROUND LEVEL

100'
4"
Casing

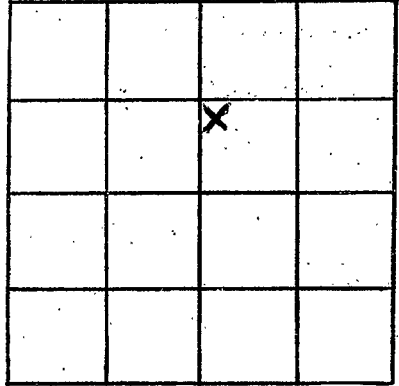

SECTION

35

Please indicate well location X.

ADDITIONAL INFORMATION

130'
2"
Casing

80' 2"
Conn. to
Screen

If more than one screen,
show locations of each on sketch.