

LOWNDES

G 2017

11-15-77

MISSISSIPPI BOARD OF WATER COMMISSIONERS  
416 North State Street  
Jackson, Mississippi 39201

WATER WELL DRILLERS LOG

Nov. 15  
date well completed

1977 Alk'sup Drilling Inc.  
firm name

Lowndes  
county well located

LANDOWNER: Mr. William L. Palmer  
P.O. Box 1292  
Columbus, MS. 39701  
(mailing address)

description of formations encountered  
Top soil clay 0 270'  
Sand 0 270'  
(No fine rock)  
just sand

WELL LOCATION:  
SW/4 Sec. 13 T. 18 N. R. 18 E. West  
IN City miles of Columbus  
(distance) (direction) (nearest town)

WELL PURPOSE: Home Use  
(home, irrigation, municipal, industrial)  
Name

WELL COMPLETION DATA:

- (1) diameter (inches) 4" 1/2"
- (2) total depth (feet) 270'
- (3) static water level (feet) 100' below top of ground.
- (4) casing 4" plastic, 180' (material) (depth)  
2" If telescope see back. (size)
- (5) screen 80' 190' (length) (depth to top)  
4" 1/2" plastic (size) (material)
- (6) pump 1/2 10 (HP) (yield gpm)  
Electric (type power)
- (7) electric log NO (yes or no)

(organization running log)

(8) how well bottom plugged CAP


DRILLERS REMARKS:

RECEIVED  
JUN 29 1978

MISS. BD. OF WATER COMMISSIONERS

If well telescopes please sketch and show depths.

GROUND LEVEL

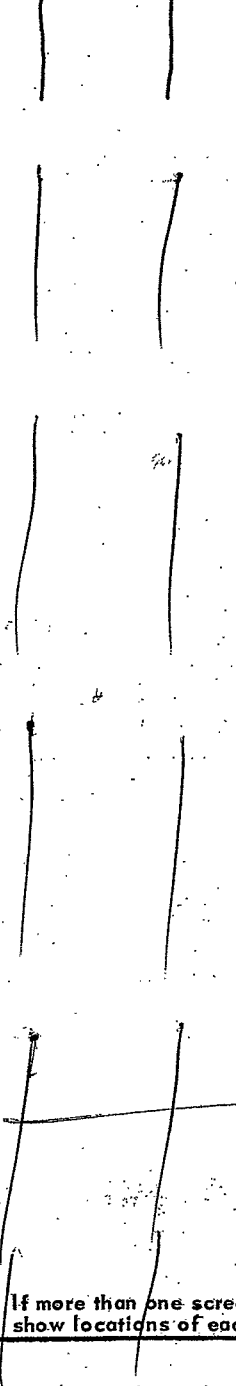


180'  
4"

270'  
2"

80'

Screen

If more than one screen, show locations of each on sketch.

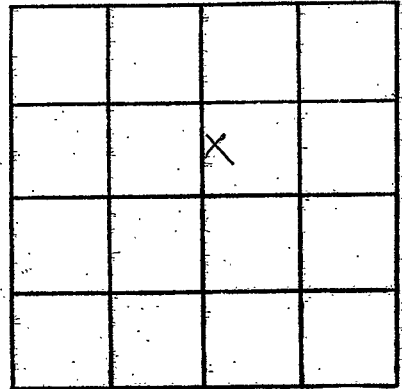

SECTION 13

Please indicate well location X.

ADDITIONAL INFORMATION

Lined area for additional information.