

LOWNDES

G 2518

3/22/78

MISSISSIPPI BOARD OF WATER COMMISSIONERS
416 North State Street
Jackson, Mississippi 39201

WATER WELL DRILLERS LOG

3-22 1978
date well completed

W.J. REEVES & SON
firm name

LOWNDES
county well located

LANDOWNER: PETE O'BRYAN

RT. 4

COLUMBUS

(mailing address)

WELL LOCATION:

sec. 35 T 18 S R 18 W

1/2 miles S of COLUMBUS
(distance) (direction) (nearest town)

WELL PURPOSE: HOME
(home, irrigation, municipal, industrial)

WELL COMPLETION DATA:

- (1) diameter (inches) 4
- (2) total depth (feet) 120
- (3) static water level (feet) 10 below above top of ground.
- (4) casing STEEL 42' (material) (depth)
- 4 (size) If telescope see back.
- (5) screen NONE (length) (depth to top)
- (size) (material)
- (6) pump 1/2 10 (HP) (yield gpm)
- ELECT (type power)
- (7) electric log NO (yes or no)

(organization running log)

(8) how well bottom-plugged OPEN

DRILLERS REMARKS:

description of formations encountered

from

to

CLAY	0	8
SAND & GRAVEL	8	24
BLUE CLAY	24	28
BLUE SAND	28	36
" CLAY	36	82
" SAND	82	120


RECEIVED

APR 18 1978

MISS. BD. OF WATER COMM

If well telescopes please sketch and show depths.

GROUND LEVEL

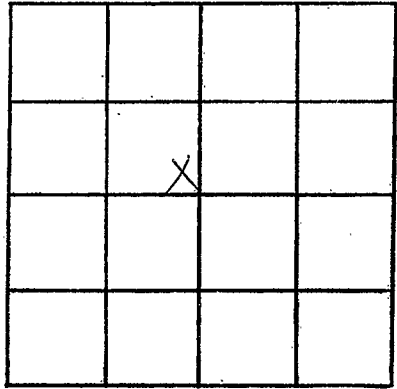

SECTION 35

Please indicate well location X.

ADDITIONAL INFORMATION

If more than one screen, show locations of each on sketch.