

LOWNDES

6 2019

5-31-78


MISSISSIPPI  
 BOARD OF WATER COMMISSIONERS  
 416 North State Street  
 Jackson, Mississippi 39201

WATER WELL DRILLERS LOG

May 31 1978 Mid-South Drilling Co.  
 date well completed firm name

Lowndes  
 county well located


<p>LANDOWNER: <u>Ralph McGinn</u>  <u>931 Deena Drive</u>  <u>Columbus, Mo. 39701</u>          (mailing address)</p>	description of formations encountered	from	to
<p>WELL LOCATION:            sec. <u>11</u> T. <u>18</u> N. R. <u>18</u> E.            S W            (distance) miles <u>east</u> of <u>Columbus</u>            (direction) (nearest town)</p>	sand	0	15
<p>WELL PURPOSE: <u>None</u>            (home, irrigation, municipal, industrial)</p>	gravel	15	25
<p>WELL COMPLETION DATA:            (1) diameter (inches) <u>4</u>            (2) total depth (feet) <u>150</u>            (3) static water level (feet) <u>36</u> below above                top of ground.            (4) casing <u>NVC</u> <u>80</u>                (material) (depth)                (size) If telescope see back.            (5) screen <u>None</u>                (length) (depth to top)                (size) (material)            (6) pump <u>None</u>                (HP) (yield gpm)                (type power)            (7) electric log <u>No</u>                (yes or no)                (organization running log)            (8) how well bottom plugged <u>open</u></p>	Clay	25	30
	Clay	30	45
	Clay - rock at 52'	45	60
	Clay	60	75
	Clay	75	90
	Clay	90	105
	sand & Clay	105	120
	sand & Clay	120	135
	Clay	135	145
	sand	145	150
<p>DRILLERS REMARKS:</p>			

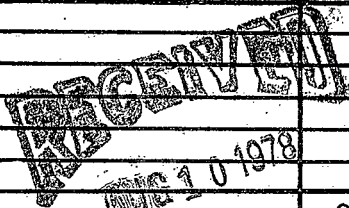

MISS. BD. OF WATER COMM.

If well telescopes please sketch and show depths.

GROUND LEVEL

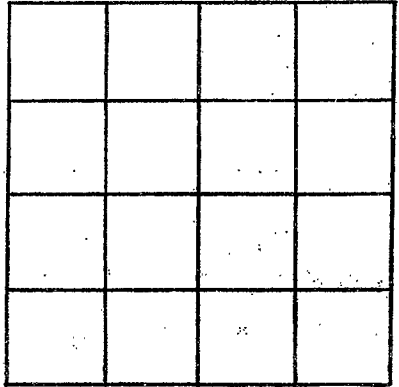

SECTION \_\_\_\_\_

Please indicate well location X.

ADDITIONAL INFORMATION

If more than one screen,  
show locations of each on sketch.