

LOWNDES

G 2020

3/23/78

MISSISSIPPI BOARD OF WATER COMMISSIONERS
416 North State Street
Jackson, Mississippi 39201

WATER WELL DRILLERS LOG

3-23-78

W. J. REEVES & SON

LOWNDES

date well completed

firm name

county well located

LANDOWNER: A. L. SLAYTON

Rt. 8 Box 46A

Columbus

(mailing address)

WELL LOCATION:

sec. 35 T. 18 N. R. 18 W. S. 4

1 miles SO of COLUMBUS
(distance) (direction) (nearest town)

WELL PURPOSE: HOME
(home, irrigation, municipal, industrial)

WELL COMPLETION DATA:

- (1) diameter (inches) 6
- (2) total depth (feet) 120
- (3) static water level (feet) 8 below above top of ground.
- (4) casing PVC 60'
(material) (depth)
6 if telescope see back.
(size)
- (5) screen NONE
(length) (depth to top)
(size) (material)
- (6) pump NONE
(HP) (yield gpm)
(type power)
- (7) electric log No
(yes or no)
(organization running log)
- (8) how well bottom plugged OPEN

description of formations encountered

from

to

SANDY CLAY	0	14
SAND & GRAVEL	14	28
BLUE CLAY	28	44
" SAND	44	49
" CLAY	49	76
" SAND	76	105
" CLAY	105	112
" SAND	112	120


DRILLERS REMARKS:

RECEIVED

APR 1 8 1978

If well telescopes please sketch and show depths.

GROUND LEVEL

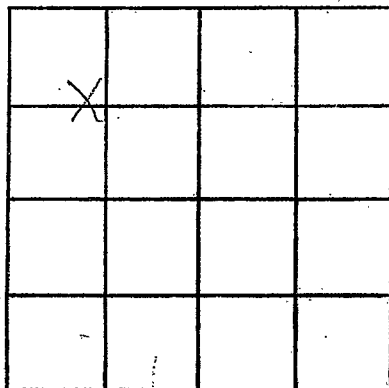

SECTION 35

Please indicate well location X.

ADDITIONAL INFORMATION

If more than one screen, show locations of each on sketch.