

LOWNDES

MISSISSIPPI BOARD OF WATER COMMISSIONERS
416 North State Street
Jackson, Mississippi 39201

WATER WELL DRILLERS LOG

April 14 1978
date well completed

Mid South Drilling
firm name

Lowndes
county well located

| LANDOWNER: <i>Miss. Paul Davis</i> | description of formations encountered | from | to |
|--|---------------------------------------|------|-----|
| <i>Columbus Miss 39701</i> (mailing address) | <i>Gravel + sand</i> | 0 | 26 |
| WELL LOCATION: sec <i>20</i> T <i>18</i> N R <i>18</i> E <i>inside city limits of Columbus</i> (distance) miles (direction) of (nearest town) | <i>clay</i> | 26 | 47 |
| WELL PURPOSE: <i>Home</i> (home, irrigation, municipal, industrial) | <i>sand</i> | 47 | 49 |
| WELL COMPLETION DATA: (1) diameter (inches) <i>4"</i> | <i>clay</i> | 49 | 58 |
| (2) total depth (feet) <i>260'</i> | <i>sand</i> | 58 | 101 |
| (3) static water level (feet) _____ below above top of ground. | <i>clay</i> | 101 | 183 |
| (4) casing <i>PVC</i> , <i>90'</i> (material) (depth) | <i>clay + sand streaks</i> | 183 | 260 |
| <i>10</i> If telescope see back. (size) | | | |
| (5) screen <i>non</i> , _____ (length) (depth to top) | | | |
| (size) _____ (material) | | | |
| (6) pump <i>none</i> , _____ (HP) (yield gpm) | | | |
| <i>electric</i> (type power) | | | |
| (7) electric log <i>none</i> , _____ (yes or no) | | | |
| <i>none</i> (organization running log) | | | |
| (8) how well bottom plugged <i>open</i> | | | |
| DRILLERS REMARKS: | | | |


RECEIVED

MAY 15 1978

MISS. BD. OF WATER COMMISSIONERS

If well telescopes please sketch and show depths.

GROUND LEVEL

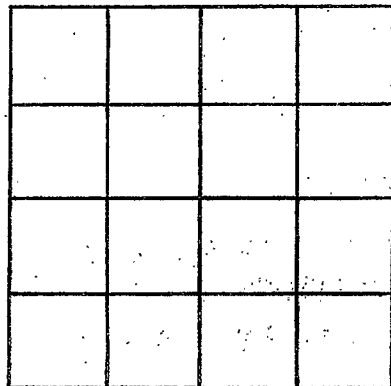

SECTION _____

Please indicate well location X.

ADDITIONAL INFORMATION

If more than one screen,
show locations of each on sketch.