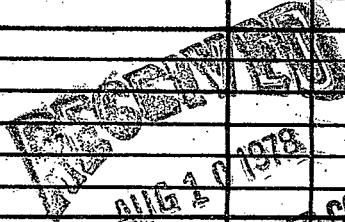


MISSISSIPPI
 BOARD OF WATER COMMISSIONERS
 416 North State Street
 Jackson, Mississippi 39201
WATER WELL DRILLERS LOG

LOWNDES
G 222
7/12/78


a July 12, 78 Mid-South Drilling Co. Lowndes
 date well completed firm name county well located

LANDOWNER: <u>Bobby Clardy</u>	description of formations encountered	from	to
<u>1005 Clardy Drive</u>			
<u>Columbus, MS 39701</u> (mailing address)	sand	0	10
	sand & gravel	10	22
	clay	22	30
	clay	30	45
WELL LOCATION:	sand	45	48
sec. <u>11</u> T. <u>18</u> S. R. <u>18</u> E.	clay	48	60
<u>1/2</u> miles <u>east</u> of <u>Columbus</u>	clay	60	85
(distance) (direction) (nearest town)	sand	85	90
WELL PURPOSE: <u>home</u> (home, irrigation, municipal, industrial)	sand	90	93
WELL COMPLETION DATA:	clay	93	97
(1) diameter (inches) <u>4</u>	sand	97	100
(2) total depth (feet) <u>170</u>	clay	100	105
(3) static water level (feet) <u>37</u> below top of ground.	clay	105	112
(4) casing <u>PVC</u> , <u>60ft.</u> (material) (depth)	sand	112	115
(size) If telescope see back.	clay	115	120
(5) screen <u>none</u> (length) (depth to top)	clay	120	125
(size) (material)	sand	125	133
(6) pump <u>none</u> (HP) (yield gpm)	clay	133	142
(type power)	sand	142	150
(7) electric log <u>none</u> (yes or no)	sand	150	170
(organization running log)			
(8) how well bottom plugged <u>open</u>			
DRILLERS REMARKS:			


 AUG 2 1978
 MISS. BD. OF WATER COM.

If well telescopes please sketch and show depths.

GROUND LEVEL

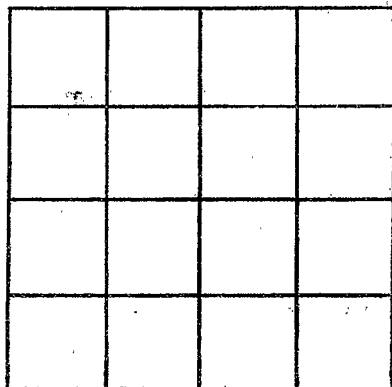

SECTION _____

Please indicate well location X.

ADDITIONAL INFORMATION

If more than one screen, show locations of each on sketch.