

LOWNDES

G  
2028

10-18-78

MISSISSIPPI  
BOARD OF WATER COMMISSIONERS  
416 North State Street  
Jackson, Mississippi 39201

WATER WELL DRILLERS LOG

Oct. 18 1978 Mid-South Oil & Gas Co. LounDes  
date well completed firm name county well located

LANDOWNER: <u>John Rice III</u> <u>Searcy &amp; Sons Insurance Agency</u> <u>122 2nd Ave South</u> <u>College Street</u> <u>Columbus MS 39701</u> (mailing address)	description of formations encountered	from	to
	clay & sand	0	15
	clay	15	35
	sand	35	45
	clay & sand	45	60
	clay	60	70
	clay & sand	70	75
	clay	75	147
	sand	147	150
	clay & sand	150	240
	clay	240	248
	sand	248	265
	clay	265	280
	sand	280	285
	clay & sand	285	290
	sand	290	300
	clay & sand	300	315

WELL LOCATION:  
sec. 4 T 18 S R. 18 E W  
inside city limits of Col.  
(distance) miles (direction) (nearest town)

WELL PURPOSE: home irrigat  
(home, irrigation, municipal, industrial)

- WELL COMPLETION DATA:
- (1) diameter (inches) 4"
  - (2) total depth (feet) 315'
  - (3) static water level (feet) \_\_\_\_\_ below/above top of ground.
  - (4) casing PVC 160  
(material) (depth)  
(size) If telescope see back.
  - (5) screen NO  
(length) (depth to top)  
(size) (material)
  - (6) pump NO  
(HP) (yield gpm)  
(type power)
  - (7) electric log NO  
(yes or no)  
NO  
(organization running log)
  - (8) how well bottom plugged open


DRILLERS REMARKS:

RECEIVED  
NOV 16 1978

MISS. Bd. OF WATER COMMISSIONERS

If well telescopes please sketch and show depths.

GROUND LEVEL

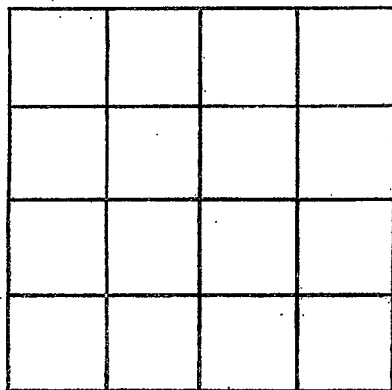

SECTION \_\_\_\_\_

Please indicate well location X.

ADDITIONAL INFORMATION

If more than one screen, show locations of each on sketch.