

LOWNDES
 G 2029
 10-19-78

MISSISSIPPI
 BOARD OF WATER COMMISSIONERS
 416 North State Street
 Jackson, Mississippi 39201

WATER WELL DRILLERS LOG

Oct. 19 1978 Mid-South Drly Co. Loundes
 date well completed firm name county well located

LANDOWNER: Nelson Chan
Lot #2
Yorkville Road
Columbus MS 39701
 (mailing address)

description of formations encountered	from	to
clay	0	8
gravel	8	18
clay	18	90
clay & sand	90	144
clay	144	150

WELL LOCATION:
 sec. 34 T 18 S R. 18 E W
1 miles S of col.
 (distance) (direction) (nearest town)

WELL PURPOSE: home
 (home, irrigation, municipal, industrial)

WELL COMPLETION DATA:

(1) diameter (inches) 4"

(2) total depth (feet) 150'

(3) static water level (feet) 15 below above top of ground.

(4) casing PVC 60
 (material) (depth)
4"
 (size) If telescope see back.

(5) screen none
 (length) (depth to top)
 (size) (material)

(6) pump 1/2 12
 (HP) (yield gpm)
ele.
 (type power)

(7) electric log no
 (yes or no)
no
 (organization running log)


(8) how well bottom plugged open

DRILLERS REMARKS:

RECEIVED
 NOV 16 1978
 MISS. BD. OF WATER COMMISSIONERS

If well telescopes please sketch and show depths.

GROUND LEVEL

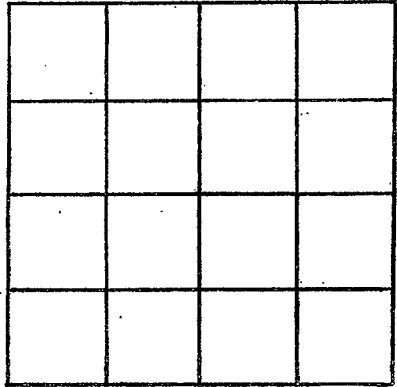

SECTION _____

Please indicate well location X.

ADDITIONAL INFORMATION

If more than one screen, show locations of each on sketch.