

LOWNDES

G 2033

12-08-78

MISSISSIPPI BOARD OF WATER COMMISSIONERS  
416 North State Street  
Jackson, Mississippi 39201

WATER WELL DRILLERS LOG

12/8 1978 Alhup Drilling Inc Lowndes  
date well completed firm name county well located

LANDOWNER: Mr. & Mrs. Ed  
Williamson  
Route 8 Box 365  
Columbus, MS. 39701  
(mailing address)

description of formations encountered	from	to
Top Soil	0	2
Gravel + Sand	2	40
Blue Rock	40	140
Sand	140	380

WELL LOCATION:

sec. 11 T. 9 S. R. 18 E  
5 miles E of Columbus  
(distance) (direction) (nearest town)

WELL PURPOSE: home  
(home, irrigation, municipal, industrial)

WELL COMPLETION DATA:

- (1) diameter (inches) 4" x 2"
- (2) total depth (feet) 380'
- (3) static water level (feet) 22' below top of ground.
- (4) casing 4" plastic, 120'  
(material) (depth)  
4" x 2" if telescope see back.  
(size)
- (5) screen 80', 300'  
(length) (depth to top)  
4" x 2", plastic  
(size) (material)
- (6) pump 1, 18  
(HP) (yield gpm)  
Electric  
(type power)
- (7) electric log NO  
(yes or no)

(organization running log)

(8) how well bottom plugged CAP

DRILLERS REMARKS:


Miss. Board of Water Comm

APR 10 1979

RECEIVED

If well telescopes please sketch and show depths.


GROUND LEVEL

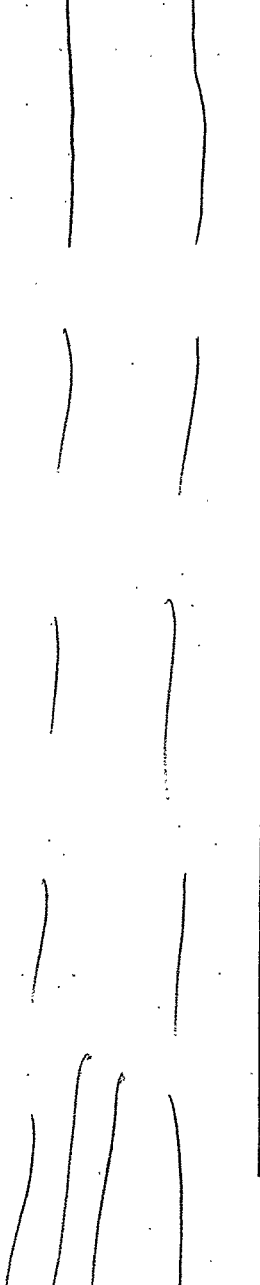

120'  
4"  
Casing

180'  
2"  
Casing

80'  
2" Concrete  
Screen

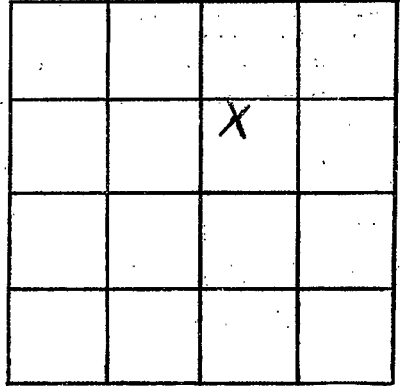

SECTION 11

Please indicate well location X.

ADDITIONAL INFORMATION

Lined area for additional information.

If more than one screen, show locations of each on sketch.