

LOWDES  
G 2035  
12-11-78

MISSISSIPPI  
BOARD OF WATER COMMISSIONERS  
416 North State Street  
Jackson, Mississippi 39201

WATER WELL DRILLERS LOG


Dec 11 1978 Mid South Drilling Landover  
date well completed firm name county well located

| LANDOWNER: P & E Homes  | description of formations encountered | from | to  |
|---|---------------------------------------|------|-----|
| Columbus MS<br>(mailing address)                                | clay                                  | 0    | 12  |
| WELL LOCATION:<br>sec. 12 T 19 N R 18 E                         | sand & gravel                         | 12   | 28  |
| 1/4 miles E of Columbus   | clay                                  | 28   | 65  |
| (distance) (direction) (nearest town)                           | clay + sand                           | 65   | 135 |
| WELL PURPOSE: home<br>(home, irrigation, municipal, industrial) |                                       |      |     |
| WELL COMPLETION DATA:   |                                       |      |     |
| (1) diameter (inches) 4"  |                                       |      |     |
| (2) total depth (feet) 135'                                     |                                       |      |     |
| (3) static water level (feet) 12' below top of ground.          |                                       |      |     |
| (4) casing PVC 68'<br>(material) (depth)                        |                                       |      |     |
| 4" if telescope see back.<br>(size)                             |                                       |      |     |
| (5) screen none<br>(length) (depth to top)                      |                                       |      |     |
| (size) (material)   |                                       |      |     |
| (6) pump 1/2 15<br>(HP) (yield gpm)                             |                                       |      |     |
| electric<br>(type power)  |                                       |      |     |
| (7) electric log no<br>(yes or no)                              |                                       |      |     |
| no<br>(organization running log)                                |                                       |      |     |
| (8) how well bottom plugged open                                |                                       |      |     |
| DRILLERS REMARKS:   |                                       |      |     |

RECEIVED  
JAN 18 1978

If well telescopes please sketch and show depths.

GROUND LEVEL

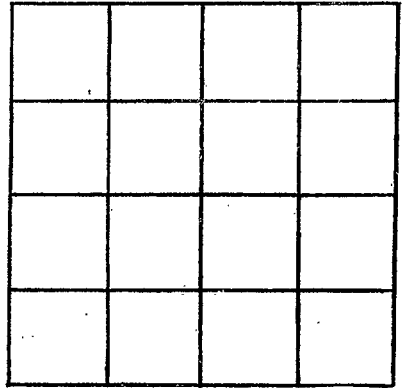

SECTION \_\_\_\_\_

Please indicate well location X.

ADDITIONAL INFORMATION

If more than one screen,  
show locations of each on sketch.