

LOWNDES
G 2038
04-30-79

**MISSISSIPPI
BOARD OF WATER COMMISSIONERS**
416 North State Street
Jackson, Mississippi 39201

WATER WELL DRILLERS LOG

April 30 1979 Mich South Drilling Lowndes
 date well completed firm name county well located

LANDOWNER: <u>R.J. Trephew</u>	description of formations encountered	from	to
<u>Columbus, MS 39701</u> (mailing address)	<u>clay</u>	<u>0</u>	<u>14</u>
WELL LOCATION: sec <u>24</u> T <u>18</u> S R <u>18</u> E S W	<u>sand & gravel</u>	<u>14</u>	<u>29</u>
<u>1</u> miles <u>SE</u> of <u>Columbus</u> (distance) (direction) (nearest town)	<u>clay</u>	<u>29</u>	<u>126</u>
WELL PURPOSE: <u>None</u> (home, irrigation, municipal, industrial)	<u>sand & clay</u>	<u>126</u>	<u>160</u>
WELL COMPLETION DATA:			
(1) diameter (inches) <u>4</u>			
(2) total depth (feet) <u>160</u>			
(3) static water level (feet) <u>30</u> below top of ground.			
(4) casing <u>PVC</u> <u>101</u> (material) (depth)			
_____ (size) if telescope see back.			
(5) screen <u>None</u> (length) (depth to top)			
_____ (size) (material)			
(6) pump <u>1/2</u> <u>5</u> (HP) (yield gpm)			
<u>electric</u> (type power)			
(7) electric log <u>no</u> (yes or no)			
_____ <u>NO</u> (organization running log)			
(8) how well bottom plugged <u>open</u>			
DRILLERS REMARKS:			


Miss. Board of Water Comm.

MAY - 3 1979

RECEIVED

If well telescopes please sketch and show depths.

GROUND LEVEL

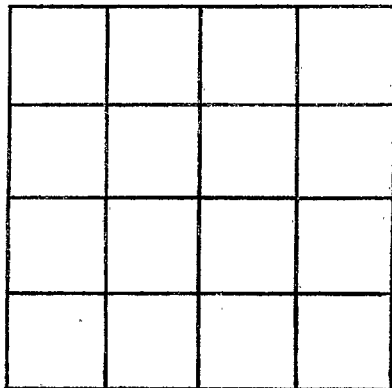

SECTION _____

Please indicate well location X.

ADDITIONAL INFORMATION

If more than one screen,
show locations of each on sketch.