

Received
 ANK
 9/24/79

Lowndes
 2040
 9-5-79

MISSISSIPPI
 BOARD OF WATER COMMISSIONERS
 416 North State Street
 Jackson, Mississippi 39201


WATER WELL DRILLERS LOG

9-5 date well completed 1979 Mid South Drilling firm name Lowndes county well located

LANDOWNER: <u>Pete O'Bryen</u>	description of formations encountered	from	to
<u>Columbus, MS</u> (mailing address)			
WELL LOCATION: sec <u>23</u> T <u>18</u> N R <u>18</u> E <u>unaided city limits</u> (distance) miles (direction) of (nearest town)	<u>clay</u>	<u>0</u>	<u>12</u>
WELL PURPOSE: <u>None</u> (home, irrigation, municipal, industrial)	<u>sand & gravel</u>	<u>12</u>	<u>150</u>
WELL COMPLETION DATA: (1) diameter (inches) <u>4</u>	<u>clay</u>	<u>50</u>	<u>100</u>
(2) total depth (feet) <u>165</u>	<u>clay & sand</u>	<u>100</u>	<u>105</u>
(3) static water level (feet) <u>25</u> below/above top of ground.	<u>clay</u>	<u>105</u>	<u>120</u>
(4) casing <u>PVC</u> <u>90</u> (material) (depth) <u>4"</u> if telescope see back. (size)	<u>clay & sand</u>	<u>120</u>	<u>165</u>
(5) screen <u>NO</u> (length) (depth to top) (size) (material)			
(6) pump <u>1/2</u> <u>10</u> (HP) (yield gpm) <u>electric</u> (type power)			
(7) electric log <u>NO</u> (yes or no) <u>NO</u> (organization running log)			
(8) how well bottom plugged <u>Open</u>			
DRILLERS REMARKS:			

If well telescopes please sketch and show depths.

GROUND LEVEL

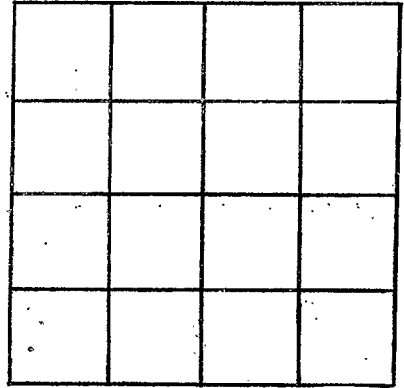

SECTION _____

Please indicate well location X.

ADDITIONAL INFORMATION

If more than one screen, show locations of each on sketch.