

Lowndes
G 2041
9-26-79

MISSISSIPPI
 BOARD OF WATER COMMISSIONERS
 416 North State Street
 Jackson, Mississippi 39201

WATER WELL DRILLERS LOG

Sept 24 date well completed Mid South Drilling firm name Lowndes county well located

LANDOWNER: <u>William Glenn</u>	description of formations encountered	from	to
<u>Columbus, MS 39701</u> (mailing address)	<u>clay</u>	<u>0</u>	<u>40</u>
	<u>sand</u>	<u>40</u>	<u>45</u>
WELL LOCATION: sec. <u>8</u> T <u>18</u> S R <u>16</u> E <u>1</u> miles <u>N</u> of <u>Columbus</u> (distance) (direction) (nearest town)	<u>clay & sand</u>	<u>45</u>	<u>88</u>
	<u>sand</u>	<u>88</u>	<u>105</u>
WELL PURPOSE: <u>Home</u> (home, irrigation, municipal, industrial)	<u>clay & sand</u>	<u>105</u>	<u>150</u>
WELL COMPLETION DATA:	<u>clay</u>	<u>150</u>	<u>180</u>
(1) diameter (inches) <u>4"</u>	<u>clay & sand</u>	<u>180</u>	<u>195</u>
(2) total depth (feet) <u>285'</u>	<u>clay</u>	<u>195</u>	<u>200</u>
(3) static water level (feet) <u>40</u> below top of ground.	<u>sand</u>	<u>200</u>	<u>210</u>
(4) casing <u>PVC</u> , <u>110'</u> (material) (depth) <u>4"</u> if telescope see back. (size)	<u>clay & sand</u>	<u>210</u>	<u>270</u>
(5) screen <u>N/A</u> (length) (depth to top)	<u>clay</u>	<u>270</u>	<u>285</u>
(size) (material)			
(6) pump <u>3/4</u> <u>10</u> (HP) (yield gpm)			
(type power)			
(7) electric log <u>NO</u> (yes or no) <u>NO</u> (organization running log)			
(8) how well bottom plugged <u>Open</u>			

DEPT. OF NATURAL RESOURCES
 DIVISION OF LAND & WATER RESOURCES
 SUITE 111


JAN 7 1980

RECEIVED

DRILLERS REMARKS:

If well telescopes please
sketch and show depths.

GROUND LEVEL

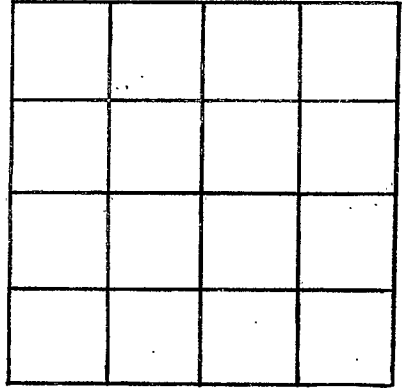

SECTION _____

Please indicate well location X.

ADDITIONAL INFORMATION

If more than one screen,
show locations of each on sketch.