

Lowndes
G 242
9-18-79
9-18

MISSISSIPPI
 BOARD OF WATER COMMISSIONERS
 416 North State Street
 Jackson, Mississippi 39201

WATER WELL DRILLERS LOG

date well completed 9-18 1979 firm name Mid South Oil Co. county well located Lowndes

LANDOWNER: Don Nevins
Columbus Ms.

description of formations encountered from to

(mailing address)

SAND 0 15

WELL LOCATION:
 sec 20 T 18 N R 18 W
12 miles W of Col.
 (distance) (direction) (nearest town)

CLAY 15 20

WELL PURPOSE: home
 (home, irrigation, municipal, industrial)

SAND & GRAVEL 20 40

WELL COMPLETION DATA:

CLAY 40 45

(1) diameter (inches) 4

CLAY & SAND 45 60

(2) total depth (feet) 255

CLAY 60 103

(3) static water level (feet) 30 below top of ground.

SAND 103 105

(4) casing PVC, 90 (material), (depth)

CLAY & SAND 105 180

4 If telescope see back. (size)

SAND 180 190

(5) screen NO (length) (depth to top)

CLAY & SAND 190 225

(size) (material)

CLAY 225 255

(6) pump 3/4 HP 10 (HP) (yield gpm)

(type power)

(7) electric log NO (yes or no)

NO (organization running log)

(8) how well bottom plugged open

DEPT. OF NATURAL RESOURCES
 BUREAU OF LAND & WATER RESOURCES


DRILLERS REMARKS:

JAN 7 1980

RECEIVED

If well telescopes please sketch and show depths.

GROUND LEVEL

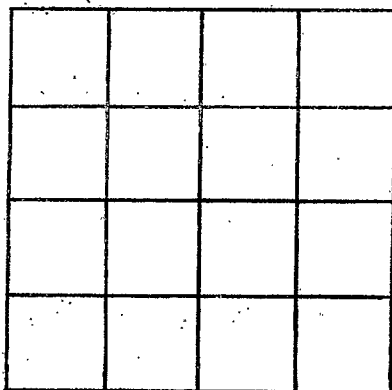

SECTION _____

Please indicate well location X.

ADDITIONAL INFORMATION

If more than one screen,
show locations of each on sketch.